IREDELL COUNTY HEALTH DEPARTMENT

STATESVILLE 704-878-5305 MOORESVILLE 704-664-5281

IMPROVEMENT PERMIT / CERTIFICATE OF COMPLETION / OPERATION PERMIT / EXISTING SYSTEM INSPECTION

PROPERTY DESCRIPTION NO. 70800 DATE 12-12-97 TAX MAP NO. 4705 N2 9400

OWNER OR CONTRACTOR Leon H. Gray PHONE: Business 872 2081 Home Watershed: ☐ Yes ☐ No

ADDRESS 311 Old Miller Rd Sta. N.C.

LOCATION 64W TL Lippard Ema Rd TL massey Dead IR vectra at end

SUBDIVISION Forest meadows BLOCK / SECTION LOT 5 LOT AREA .87 acres SITE CLASS. PS DESIGN FLOW 360 L.T.A.R. .3 gal/sq ft/day

Septic Tank: 1000 Gallons; STB 1012 Date 2-16-98

Pump Tank: Gallons; PT Date

Pump Make: Model Serial No.

Nitrification Field: No Fields 1 Square Feet 1200 Linear Feet 400

No Lines 3 Trench Width 36" Max Trench Bottom Depth 36" Gravel Depth 12"

☑ New System ☐ Repair System Type: I (II) III, IV, V, VI

System Description: Conv. Gravity

Repair System Description: Pump To Chambers

Maintenance Agreement Required: ☐ Yes ☑ No

☐ House/Mod. Home ☑ Mobile Home ☐ Business ☐ Other

No. Bedrooms 3 No. Bathrooms 2 No. Employees

☐ Slab ☑ Crawl Space ☐ Basement w/plumbing ☐ Basement wo/plumbing


Water Supply: ☐ Individual ☐ Community ☑ Public

Comments:

street


193'

INITIAL SITE SKETCH

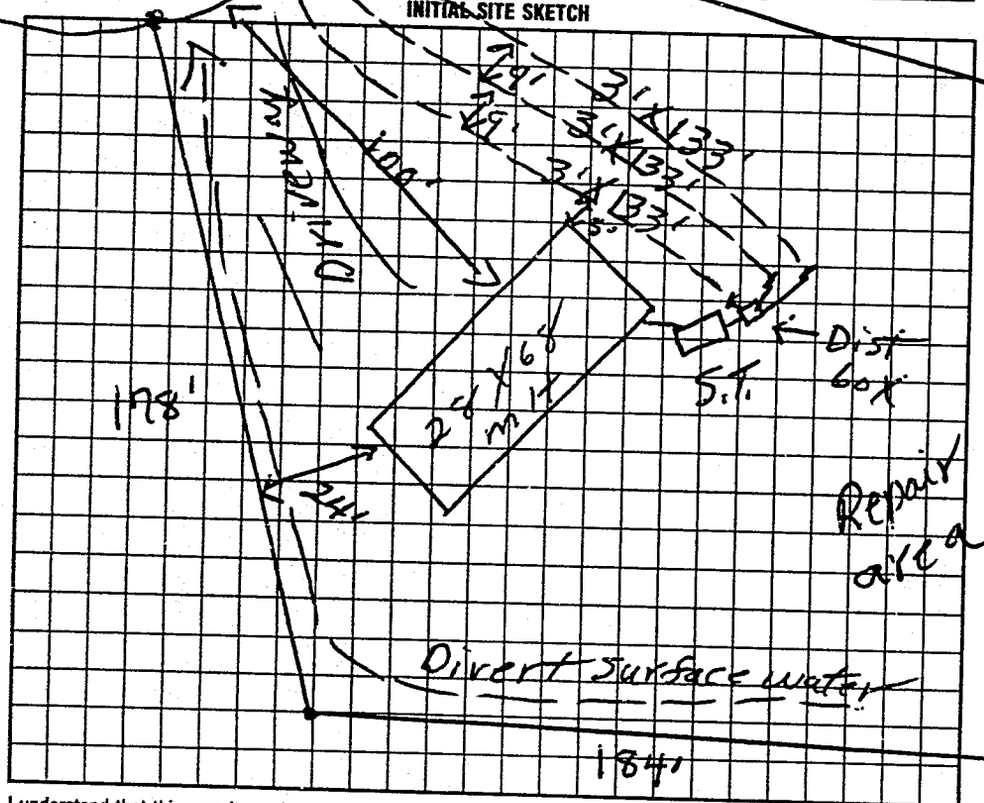

Comments:

AS BUILT SKETCH

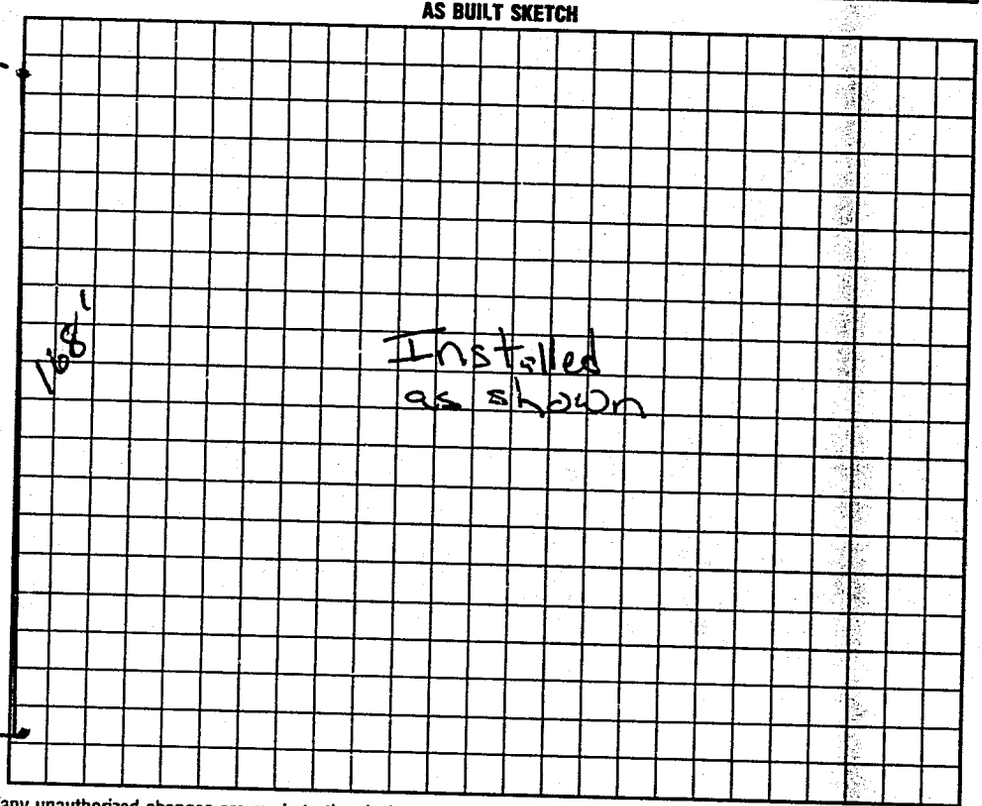

I understand that this permit can be suspended or revoked if any false information is supplied toward securing the permit/any unauthorized changes are made to the site/any unauthorized changes are made in the installation of the system. Improvement Permit is valid for 60 months from date of issuance.

Signed: Leon Gray

Improvement Permit by: C.C. Moore date 12-12-97

Authorization Existing System Inspection by: C.C. Moore date 12-12-97

to cont.

Installed by: Steve Jordan

Certificate of Completion by: date

Operation Permit by: Mat C OS RS date 4-27-98

HEALTH DEPT. COPY: WHITE INSPECTION COPY (FINAL): GREEN OWNER COPY (FINAL): YELLOW INSPECTION COPY (INITIAL): PINK OWNER COPY (INITIAL): GOLD

Authorization to cont Expires 60 mos from issue