This Voids Previous Permits

IREDELL COUNTY HEALTH DEPARTMENT

STATESVILLE 704-878-5305 MOORESVILLE 704-664-5281

IMPROVEMENT PERMIT / AUTHORIZATION TO CONSTRUCT / OPERATION PERMIT / EXISTING SYSTEM INSPECTION

PERMIT# 88066 PIN# 4705729766 DATE May 24, 2000

OWNER OR CONTRACTOR William Hucke PHONE: Business 876 4886 Home

ADDRESS 125 Monica Dr Olin NC

LOCATION Old MTRd Nth (B) Massey Dead Cross Lippard Farm (R) Vectra 2nd Lot on Right

SUBDIVISION Forest Meadow BLOCK / SECTION LOT 7 LOT AREA .80 Ac SITE CLASS 15 DESIGN FLOW 360 L.T.A.R. .3

Septic Tank: 1000 Gallons: STB 1012 Date 3/1/00
Pump Tank: Gallons: PT Date
Pump Make: Model Serial No.
Nitrification Field: No Fields 1 Square Feet 1200 Linear Feet 300
No Lines 5 Trench Width 36" Max Trench Bottom Depth 30" Gravel Depth N/A

☒ New System ☐ Repair System Type: I, II, (III), IV, V, VI
System Description: Gravity 25% Reduction
Repair System Description: Pump 25% Reduction
Maintenance Agreement Required ☐ Yes ☒ No


☐ House/Mod. Home No. Bedrooms 3
☒ Mobile Home ΔW No. Bathrooms 2
☐ Business No. Employees
☐ Other
☐ Slab ☒ Crawl Space ☐ Basement w/plumbing ☐ Basement wo/plumbing

Water Supply: ☐ Individual ☒ Public ☐ Community


Comments/Conditions: 50 Chambers or HS Sections 30
Install on contour as flagged- Divert surface H2o away from system. Subsurface Diversion Ditch To be PL 215

Comments/Conditions
Installed at 42" out to day light Fill w/Rock 6" to Top.

INITIAL SITE SKETCH

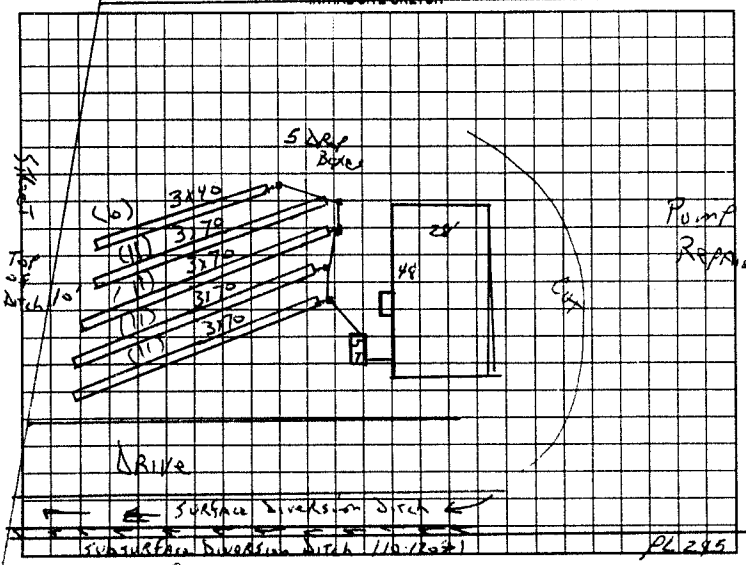

AS BUILT SKETCH

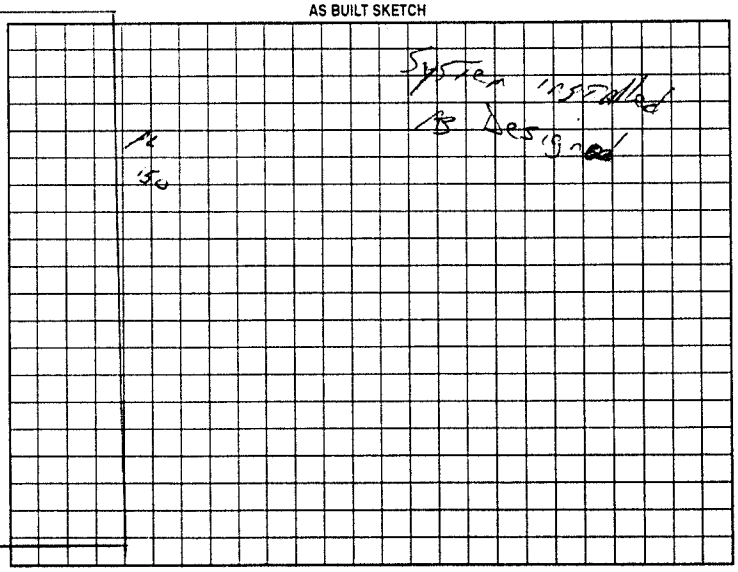

Permit can be suspended or revoked if any false information is supplied toward securing the permit/any unauthorized changes are made to the site/any unauthorized changes are made in the installation of the system. Improvement Permit with plat valid without expiration. Improvement Permit with site plan valid for sixty months. Authorization to Construct is valid for a period equal to that of Improvement Permit – not to exceed sixty months.

Signed: Leon Gray date Installed by: Ed Reat, Elder

Improvement Permit by: J.C. Potter date May 24 2000 Operation Permit by: J.C. Potter date May 24, 2000

Authorization to Construct by: J.C. Potter date May 24 2000 Existing System Inspection by: date

HEALTH DEPT. COPY: WHITE OWNER COPY (FINAL): YELLOW OWNER COPY (INITIAL): PINK