IREDELL COUNTY HEALTH DEPARTMENT

65494

STATESVILLE 704-878-5305 MOORESVILLE 704-664-5281

IMPROVEMENT PERMIT / CERTIFICATE OF COMPLETION / OPERATION PERMIT / EXISTING SYSTEM INSPECTION

PROPERTY DESCRIPTION NO. 26188 DATE 3-10-97 TAX MAP NO. 4705732570 Watershed: ☐ Yes ☒ No

OWNER OR CONTRACTOR Leon Gray PHONE: Business 872-2081 Home

ADDRESS 2027 Shelton Ln Statesville

LOCATION 64 W TL Lippard Farm TL Massey Dead Rd TL Little Valley Ln 2nd lot on Right

SUBDIVISION Forest Meadows BLOCK / SECTION LOT 3 LOT AREA 120x363 SITE CLASS P/S DESIGN FLOW 360 L.T.A.R. 0.3

Septic Tank: 1000 Gallons; STB 1012 Date 12-29-97

Pump Tank: Gallons; PT Date

Pump Make: Model Serial No.

Nitrification Field: No Fields 1 Square Feet 600 Linear Feet 200

No Lines 4 Trench Width 24in Max Trench Bottom Depth 36in Gravel Depth Sand

☒ New System ☐ Repair System Type: I, II, III, IV, V, VI

System Description: Gravity Panel

Repair System Description: Pump Panel

Maintenance Agreement Required: ☐ Yes ☒ No

☐ House/Mod. Home ☒ Mobile Home ☐ Business ☐ Other

No. Bedrooms 3 No. Bathrooms 2 No. Employees


Water Supply: ☐ Individual ☐ Community ☒ Public

☐ Slab ☐ Crawl Space ☐ Basement w/plumbing ☐ Basement wo/plumbing


Comments: Keep lines on contour 8 ft on centers Lime Trench walls, keep lines 50ft from well

Comments: Paid $150.- ck. 1758 CH

INITIAL SITE SKETCH

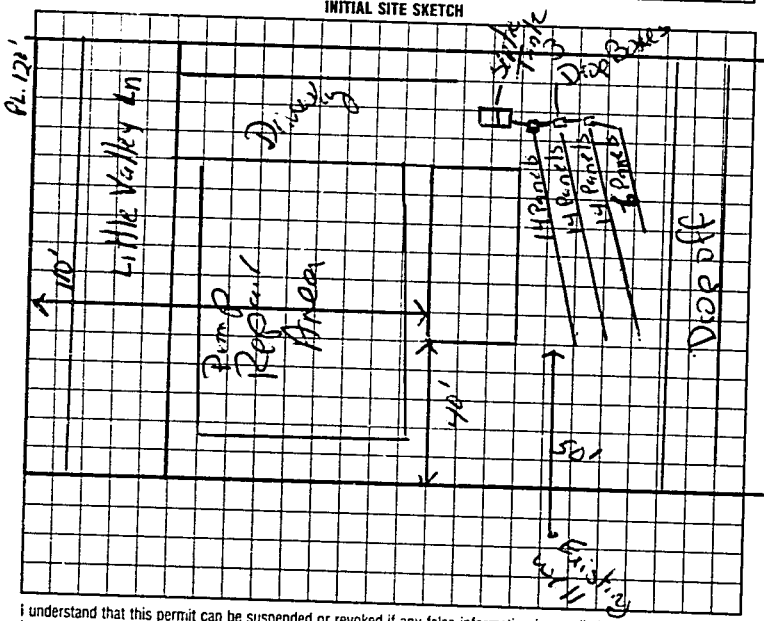

AS BUILT SKETCH

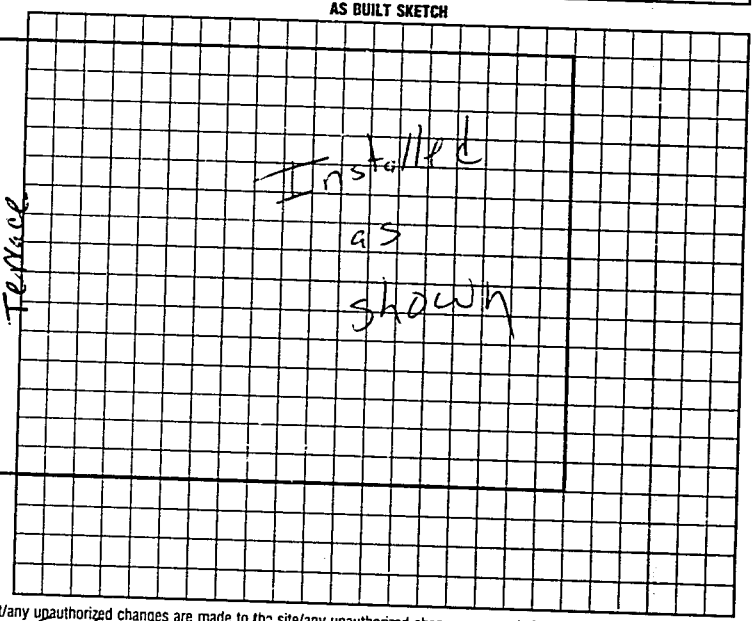

I understand that this permit can be suspended or revoked if any false information is supplied toward securing the permit/any unauthorized changes are made to the site/any unauthorized changes are made in the installation of the system. Improvement Permit is valid for 60 months from date of issuance. Authorization to construct expires 5 yrs from issue date

Signed: Leon Gray

Improvement Permit by: Authorization Denied. Mark C Otts date 3-10-97

Existing System Inspection by: Mark C Otts date 3-10-97

Installed by: Donald Lucky

Certificate of Completion by: date

Operation Permit by: Mark C Otts JLS date 4-14-97

HEALTH DEPT. COPY: WHITE | INSPECTION COPY (FINAL): GREEN | OWNER COPY (FINAL): YELLOW | INSPECTION COPY (INITIAL): PINK | OWNER COPY (INITIAL): GOLD