11:00

IREDELL COUNTY HEALTH DEPARTMENT

STATESVILLE 704-878-5305 MOORESVILLE 704-664-5281

IMPROVEMENT PERMIT / AUTHORIZATION TO CONSTRUCT / OPERATION PERMIT / EXISTING SYSTEM INSPECTION

PERMIT# 83004 PIN# 4708736343 DATE Aug 5, 99

OWNER OR CONTRACTOR GRAYCREST Homes Inc PHONE: Business 872-2081 Home

ADDRESS 2027 Shelton Ln Statesville

LOCATION I-40 W (R) Stamey Farm Exit (L) Island End (R) Legrand Farm (R) Misty Dell on left 2nd Lot past Little Valley Lane

SUBDIVISION Forest Meadows BLOCK / SECTION LOT 6 LOT AREA .76 SITE CLASS PS DESIGN FLOW 360 L.T.A.R. .3

Septic Tank: 1000 Gallons; STB 821 Date 6/10/00
Pump Tank: Gallons; PT Date
Pump Make: Model Serial No.
Nitrification Field: No Fields 1 Square Feet 1200 Linear Feet 400
No Lines 4 @ 100 Trench Width 36" Max Trench Bottom Depth 36" Gravel Depth 12"

☒ New System ☐ Repair System Type: I (II) III, IV, V, VI
System Description: Conv. GRAVITY
Repair System Description: SAME
Maintenance Agreement Required: ☐ Yes ☒ No


☐ House/Mod. Home No. Bedrooms 3
☒ Mobile Home 1 W No. Bathrooms 2
☐ Business No. Employees
☐ Other
☐ Slab ☒ Crawl Space ☐ Basement w/plumbing ☐ Basement wo/plumbing

Water Supply: ☐ Individual ☒ Public ☐ Community


Comments/Conditions: Use 4 Drop Boxes or 3 Flow divider Tees
MAINTAIN all setbacks

Comments/Conditions

INITIAL SITE SKETCH

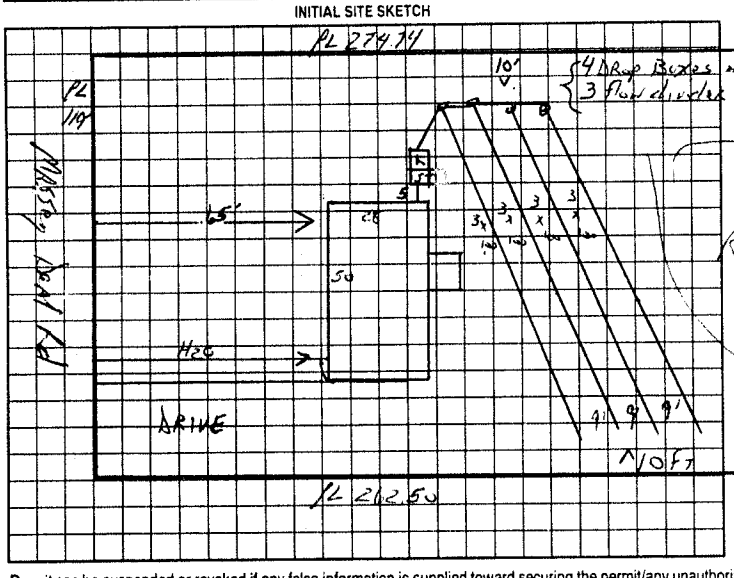

AS BUILT SKETCH

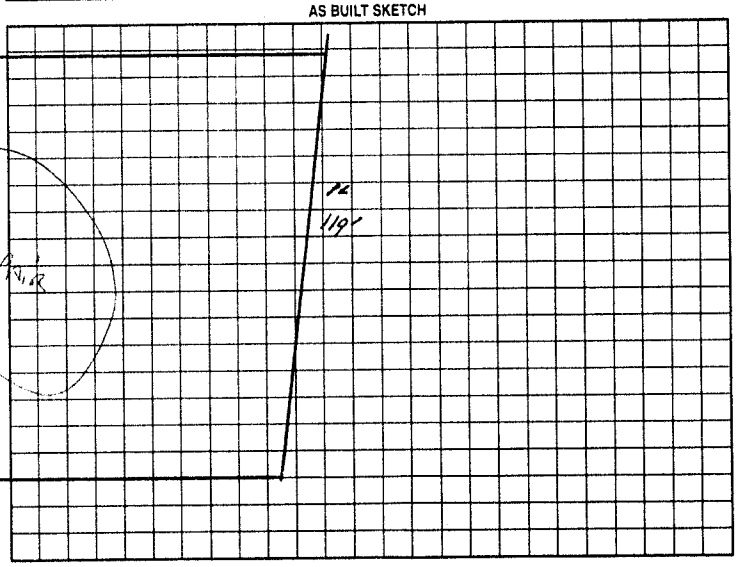

Permit can be suspended or revoked if any false information is supplied toward securing the permit/any unauthorized changes are made to the site/any unauthorized changes are made in the installation of the system. Improvement Permit with plat valid without expiration. Improvement Permit with site plan valid for sixty months. Authorization to Construct is valid for a period equal to that of Improvement Permit – not to exceed sixty months.

Signed: Leon N. Gray date 8-6-99 Installed by: Ward Grading

Improvement Permit by: L. Potter date 8-5-99 Operation Permit by: [illegible] RSI date 10/19/00

Authorization to Construct by: L. Potter date 8-5-99 Existing System Inspection by: date

HEALTH DEPT COPY: WHITE OWNER COPY (FINAL): YELLOW OWNER COPY (INITIAL): PINK