IREDELL COUNTY HEALTH DEPARTMENT

STATESVILLE 704-878-5305 MOORESVILLE 704-664-5281

IMPROVEMENT PERMIT / CERTIFICATE OF COMPLETION / OPERATION PERMIT / EXISTING SYSTEM INSPECTION

PROPERTY DESCRIPTION NO. 065899 DATE 4-11-97 ~~TAX MAP NO~~ PINNO. 4705 739963 Watershed: ☐ Yes ☐ No

OWNER OR CONTRACTOR Leon Gray PHONE: Business 704 872 2051 Home

ADDRESS 311 Old Mill Rd

LOCATION 64 E TL Lippard Emery TL marsh Real TL Excel Dr. 300' left

SUBDIVISION Forestmeade BLOCK / SECTION LOT LOT AREA .40 acres SITE CLASS. PS DESIGN FLOW 360 L.T.A.R. 1.3

Septic Tank: 1000 Gallons; STB 1017 Date 3-24-97

Pump Tank: Gallons; PT Date

Pump Make: Model Serial No.

Nitrification Field: No Fields 1 Square Feet 1200 Linear Feet 400

No Lines 3 Trench Width 36 Max Trench Bottom Depth 36 Gravel Depth 12"

☑ New System ☐ Repair System Type: I, ☒ III, IV, V, VI

System Description: Conv. Gravity

Repair System Description: " "

Maintenance Agreement Required: ☐ Yes ☒ No

☐ House/Mod. Home No. Bedrooms 3

☑ Mobile Home No. Bathrooms 2

☐ Business No. Employees

☐ Other


☐ Slab ☑ Crawl Space ☐ Basement w/plumbing ☐ Basement wo/plumbing

Water Supply: ☐ Individual ☐ Community ☑ Public


Comments:

Comments:
* Lines are deep (approx 4ft)
Tank off rear corner

INITIAL SITE SKETCH

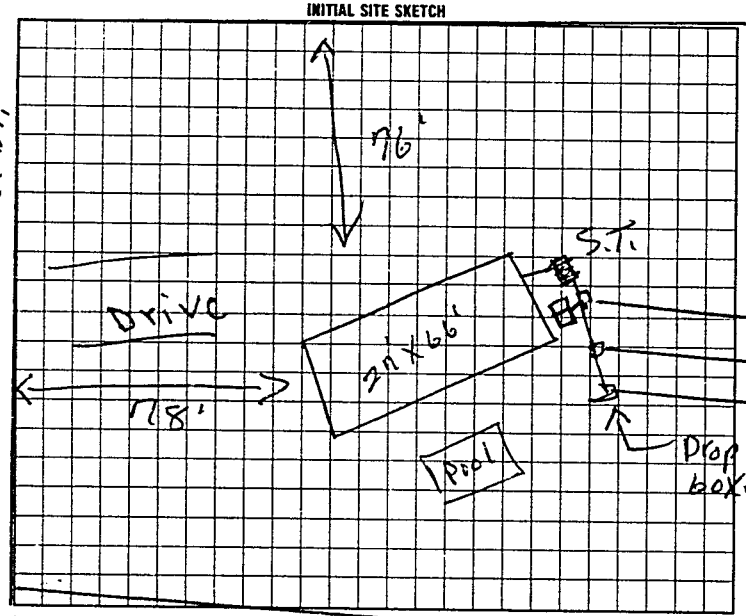

AS BUILT SKETCH

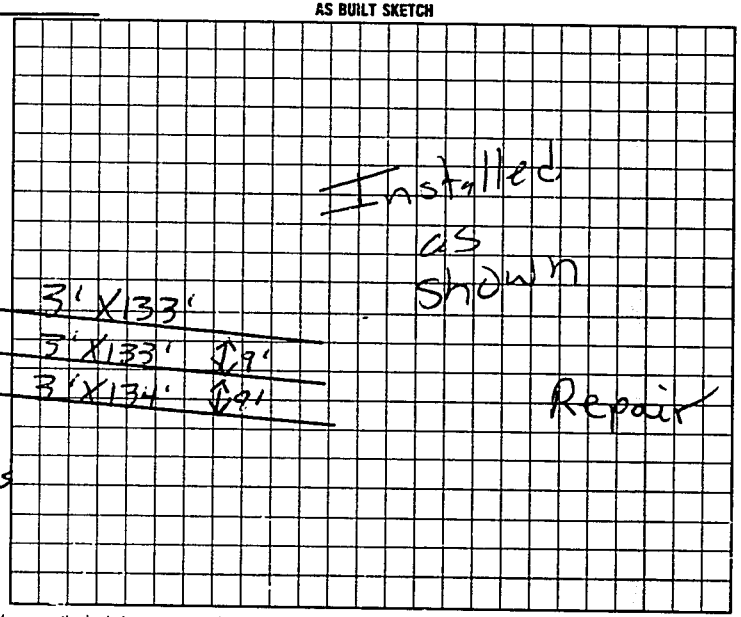

I understand that this permit can be suspended or revoked if any false information is supplied toward securing the permit/any unauthorized changes are made to the site/any unauthorized changes are made in the installation of the system. Improvement Permit is valid for 60 months from date of issuance.

Signed: X Leon Gray

Improvement Permit by: L.C. Moore date 4-11-97

Authorization To Construct by: L.C. Moore date 4-11-97

Installed by: Dale Fox

Certificate of Completion by: date

Operation Permit by Mark C Ort date 5-15-97

WHITE: APPLICANT COPY; INSPECTION COPY (FINAL): GREEN; OWNER COPY (FINAL): YELLOW; INSPECTION COPY (INITIAL): PINK; OWNER COPY (INITIAL): GOLD

Authorization to Const Expires 60 mos From Issue

694000