IREDELL COUNTY HEALTH DEPARTMENT — Authorization to construct #64428

STATESVILLE 704-878-5305 MOORESVILLE 704-664-5281

IMPROVEMENT PERMIT / ~~CERTIFICATE OF COMPLETION~~ / OPERATION PERMIT / EXISTING SYSTEM INSPECTION

PROPERTY DESCRIPTION NO. 25467 DATE 11-27-96 TAX MAP NO. 8I A 5

OWNER OR CONTRACTOR Leon Gray (Steve Sutherland) Watershed: ☐ Yes ☒ No

ADDRESS Rt 10 Box 558 Statesville PHONE: Business 872-2061 Home 838-0914

LOCATION 64 W TL Leopard Farm Rd TL Massey Deal Rd lot 6 on left

SUBDIVISION Forest Meadows BLOCK / SECTION III LOT 6 LOT AREA 0.719 SITE CLASS. PS DESIGN FLOW 480 L.T.A.R. 0.3

Septic Tank: 1000 Gallons; STB 1012 Date 10-5-96
Pump Tank: Gallons; PT Date
Pump Make: Model Serial No.
Nitrification Field: No Fields 1 Square Feet 1600 Linear Feet 533
No Lines 6 Trench Width 36 in Max Trench Bottom Depth 36 in Gravel Depth 12

☒ New System ☐ Repair System Type: I, II, III, IV, V, VI
System Description: Gravity Conventional
Repair System Description: Gravity Chamber Hanne
Maintenance Agreement Required: ☐ Yes ☒ No
☐ Slab ☐ Crawl Space ☐ Basement w/plumbing ☐ Basement wo/plumbing


☐ House/Mod. Home ☒ Mobile Home ☐ Business ☐ Other
No. Bedrooms 4 No. Bathrooms 2 No. Employees

Water Supply: ☐ Individual ☐ Community ☒ Public


Comments: keep lines on contour, 9 ft on center

Comments: 1-14-97 - Checked tank, first 2 lines
1-15-97 - Checked remaining lines

INITIAL SITE SKETCH

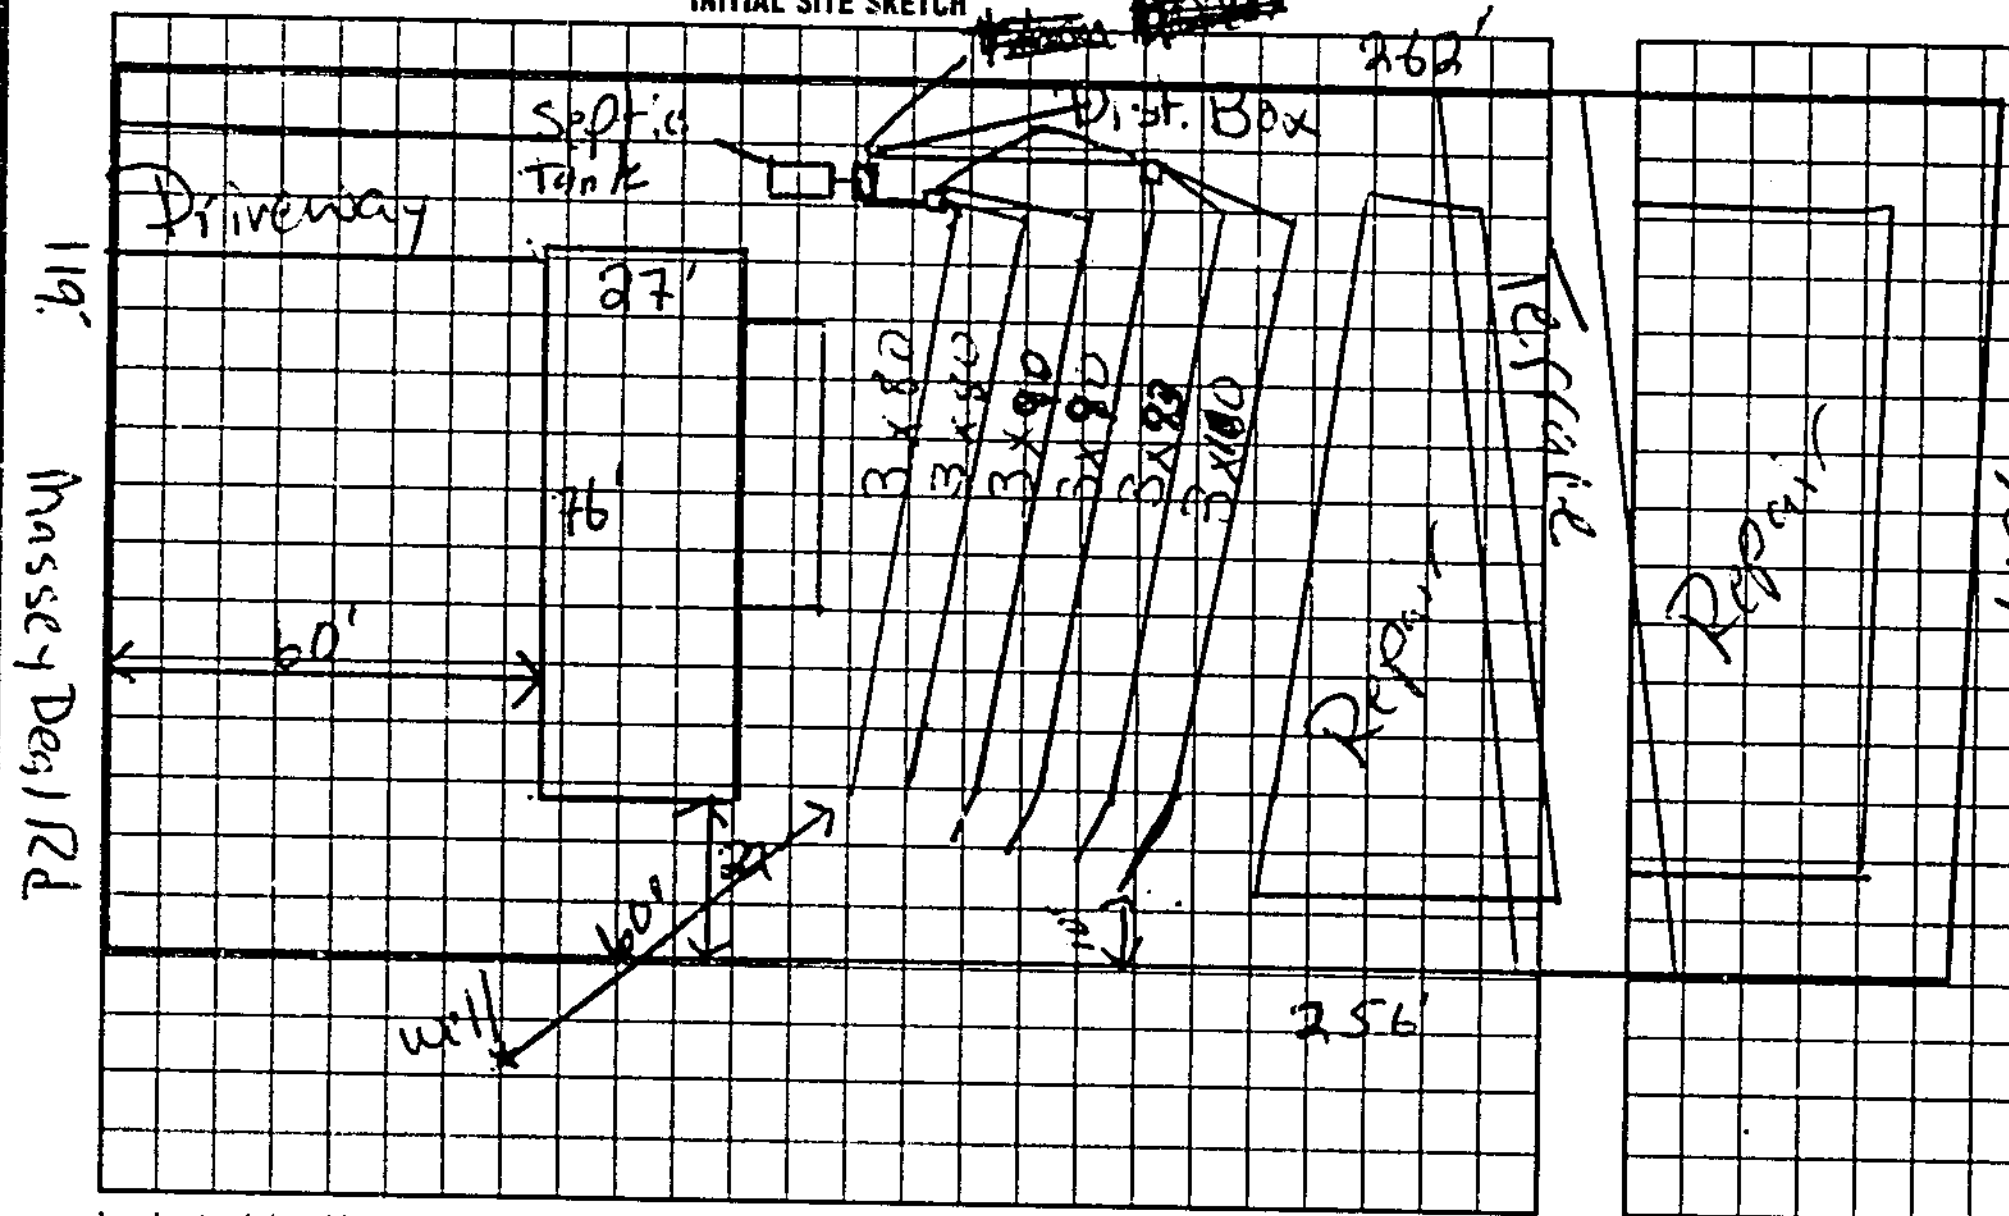

AS BUILT SKETCH

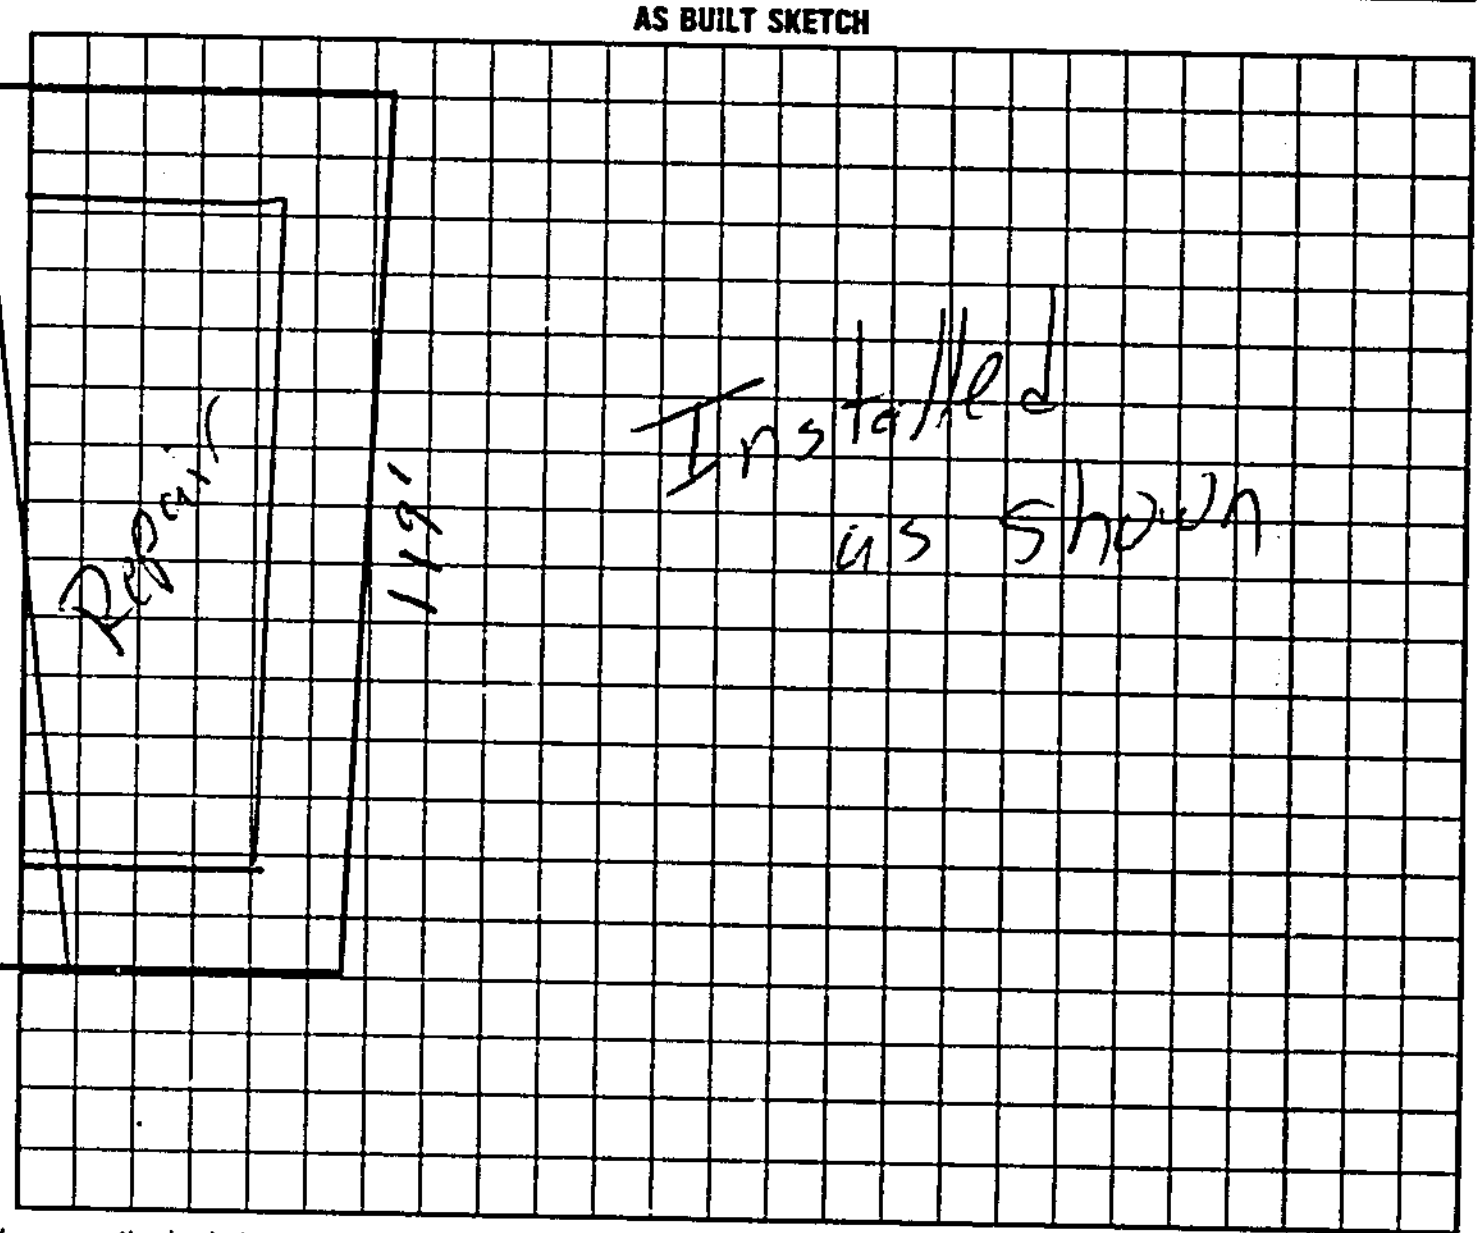

I understand that this permit can be suspended or revoked if any false information is supplied toward securing the permit/any unauthorized changes are made to the site/any unauthorized changes are made in the installation of the system.
Improvement Permit is valid for 60 months from date of issuance. Authorization to const. expires 5 yrs from issue date

Signed x Leon Gray

Improvement Permit by: [signature] RS date 11-27-96

~~Existing System Inspection by:~~ Authorization to const. [signature] RS date 11-27-96

Installed by: Dale Fox

Certificate of Completion by: date

Operation Permit by: [signature] RS date 1-15-97

HEALTH DEPT. COPY: WHITE INSPECTION COPY (FINAL): GREEN OWNER COPY (FINAL): YELLOW INSPECTION COPY (INITIAL): PINK OWNER COPY (INITIAL): GOLD

962000