IREDELL COUNTY HEALTH DEPARTMENT

STATESVILLE 704-878-5305 (O) (C) MOORESVILLE 704-664-5281

IMPROVEMENT PERMIT / AUTHORIZATION TO CONSTRUCT / OPERATION PERMIT / EXISTING SYSTEM INSPECTION

PERMIT# 104563 PIN# 4705 75 9586 DATE 4/10/02

OWNER OR CONTRACTOR STONES EDGE PHONE: Business 663-2220 Home

ADDRESS 130 LAZY LANE MOORESVILLE

LOCATION 64 W - TL LIPPARD FARM - TL STONES EDGE - TL GEMSTONE - TR ZERCON - ON RT

SUBDIVISION STONES EDGE BLOCK / SECTION LOT 106 LOT AREA .52 SITE CLASS PS DESIGN FLOW 360GPD L.T.A.R. .26 AC/RT

Septic Tank: 1000 Gallons: STB 1012 Date 12-7-02

Pump Tank: Gallons: PT Date

Pump Make: Model Serial No.

Nitrification Field: No Fields 1 Square Feet 1206 Linear Feet 400

No Lines @ 5'C80" Trench Width 36" Max Trench Bottom Depth 36" Gravel Depth 12"

☒ New System ☐ Repair System Type: I (II) III IV V VI

System Description: GRAVITY CONVENTIONAL

Repair System Description: INNOVATIVE

Maintenance Agreement Required: ☐ Yes ☒ No

☐ Slab ☒ Crawl Space ☐ Basement w/plumbing ☐ Basement wo/plumbing

☐ House/Mod. Home ☒ Mobile Home ☐ Business ☐ Other


No. Bedrooms 3 No. Bathrooms 3 No. Employees

Water Supply: ☐ Individual ☒ Public ☐ Community

Comments/Conditions:

Comments/Conditions: SEPTIC TANK WITH MARKER INSTALLED USING "POLYLOK" FILTER

INITIAL SITE SKETCH 1"=50'

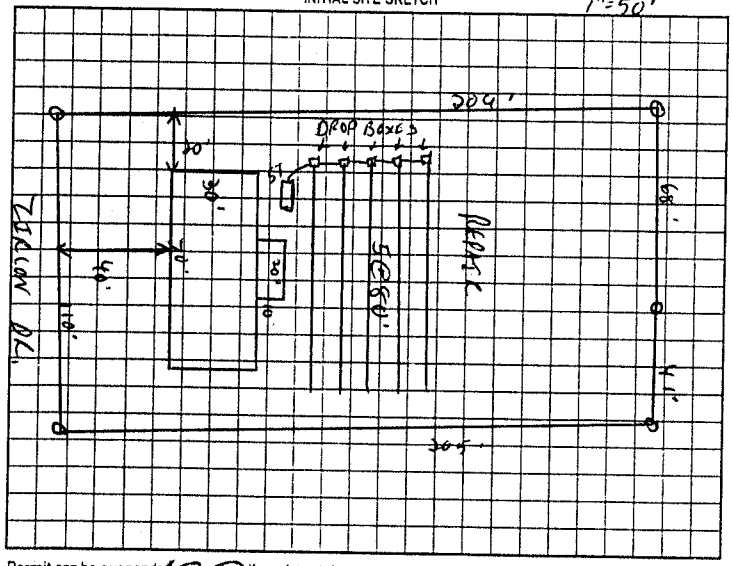

AS BUILT SKETCH

SYSTEM INSTALLED ACCORDING TO INITAL SITE SKETCH

Permit can be suspended or revoked if any false information is supplied toward securing the permit/any unauthorized changes are made to the site/any unauthorized changes are made in the installation of the system. Improvement Permit with plat valid without expiration. Improvement Permit with site plan valid for sixty months. Authorization to Construct is valid for a period equal to that of Improvement Permit – not to exceed sixty months

Signed: date 4/10-02

Improvement Permit by: KS date 4/10/02

Authorization to Construct by: KS date 4/10/02

Installed by: TOMMY COTHREN

Operation Permit by: STEVE HENDRICK date 5-3-02

Existing System Inspection by: date

HEALTH DEPT. COPY: WHITE OWNER COPY (FINAL): YELLOW OWNER COPY (INITIAL): PINK