IREDELL COUNTY HEALTH DEPARTMENT

STATESVILLE 704-878-5305 (1) MOORESVILLE 704-664-5281

IMPROVEMENT PERMIT / AUTHORIZATION TO CONSTRUCT / OPERATION PERMIT / EXISTING SYSTEM INSPECTION

PERMIT# 10997 PIN# 4705-76-5002 DATE 12/24/04

OWNER OR CONTRACTOR Stones Edge Inc. PHONE: Business (704) 663-2220 Home —

ADDRESS 130 Lazy Lane Mooresville N.C. 28625

LOCATION Hwy 64 West (R) Liptars Farm Rd, (L) Stones Edge Rd, (L) on Gemstone lot on left (3rd Lot on West)

SUBDIVISION Stonesedge BLOCK / SECTION — LOT 3 LOT AREA .505 AC SITE CLASS. P5 DESIGN FLOW 480 L.T.A.R. .30

Septic Tank: 1,000 Gallons; STB 1012 Date 7-3-04

Pump Tank: _____ Gallons; PT _____ Date _____

Pump Make: _____ Model _____ Bal. to _____ Serial No. _____

Nitrification Field: No Fields 1 Square Feet 1600 Linear Feet 270

No Lines 6@45 Trench Width 2ft Max Trench Bottom Depth 36" Gravel Depth 6"

☒ New System ☐ Repair System Type: I, II, (III), IV, V, VI

System Description: Gravity Panel Block System

Repair System Description: Pump LP Panel

Maintenance Agreement Required: ☐ Yes ☒ No

☐ House/Mod. Home No. Bedrooms 4

☒ Mobile Home No. Bathrooms ____

☐ Business No. Employees ____

☐ Other ____


☐ Slab ☒ Crawl Space ☐ Basement w/plumbing ☐ Basement wo/plumbing

Water Supply: ☐ Individual ☒ Public ☐ Community

Comments:/Conditions: (1) Install 60 Panel Blocks w/145 tons of Sand (2) use one(1) flow divider tee + two(2) effluent splitters (Such as Zoller Tra-flow divider)

Comments:/Conditions: SEPTIC TANK WITH MARKER INSTALLED USING "TUFTITE" FILLER

INITIAL SITE SKETCH 1" = 50'

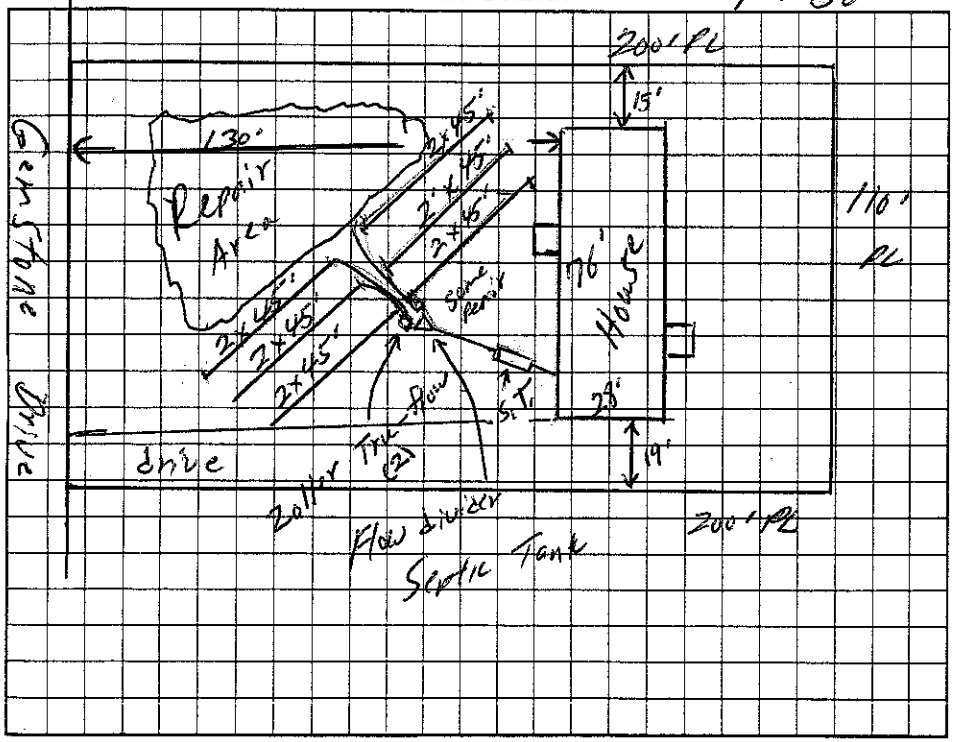

AS BUILT SKETCH

SYSTEM INSTALLED ACCORDING TO INITIAL SITE SKETCH

Permit can be suspended or revoked if any false information is supplied toward securing the permit/any unauthorized changes are made to the site/any unauthorized changes are made in the installation of the system. Improvement Permit with plat valid without expiration. Improvement Permit with site plan valid for sixty months. Authorization to Construct is valid for a period equal to that of Improvement Permit – not to exceed sixty months.

Signed: Lena Johnston date 12/20/04 Installed by: A-1 BACKHOE

Improvement Permit by: William O. John date 12/24/04 Operation Permit by: STEVE HORICK date 1-3-05

Authorization to Construct by: William O. John date 12/24/04 Existing System Inspection by: _____ date _____

HEALTH DEPT. COPY: WHITE OWNER COPY (FINAL): YELLOW OWNER COPY (INITIAL): PINK