IREDELL COUNTY HEALTH DEPARTMENT

STATESVILLE 704-878-5305 CI 175.00 Paid MOORESVILLE 704-664-5281

IMPROVEMENT PERMIT / AUTHORIZATION TO CONSTRUCT / OPERATION PERMIT / EXISTING SYSTEM INSPECTION

PERMIT# 104079 PIN# 4705 76 5245 DATE 1/15/02

OWNER OR CONTRACTOR JOHNNY CLAVER PHONE: Business 663-2220 Home

ADDRESS 130 LAZY LANE MOORESVILLE 28117

LOCATION 64N - TL LEOPARD FARM - TL STONES EDGE - TL GEMSTONE - ON LT

SUBDIVISION STONES EDGE BLOCK / SECTION LOT 5 LOT AREA 1.67 AC SITE CLASS. DS DESIGN FLOW 360GPD L.T.A.R. .36/1.2

Septic Tank: 1000 Gallons; STB 1012 Date 5-29-02
Pump Tank: Gallons; PT Date
Pump Make: Model Serial No.
Nitrification Field: No Fields 1 Square Feet 900 Linear Feet 300
No Lines 4@75' Trench Width 36" Max Trench Bottom Depth 36"

~~New System~~ ☐ Repair System Type: I, II, (III), IV, V, VI
System Description: GRAVITY 25% REDUCTION
Repair System Description: LP PANEL
Maintenance Agreement Required: ☐ Yes ~~No~~


~~House/Mod. Home~~ No. Bedrooms 3
☑ Mobile Home No. Bathrooms 3
☐ Business No. Employees
☐ Other
Gravel Depth N/A
☐ Slab ☑ Crawl Space ☐ Basement w/plumbing ☐ Basement wo/plumbing

Water Supply: ☐ Individual ~~Public~~ ☐ Community


Comments:/Conditions:

Comments:/Conditions:
Leaf Tite Filter
Septic Tank marker Installed
300 FT E-2 Box Installed

INITIAL SITE SKETCH 1"=50'

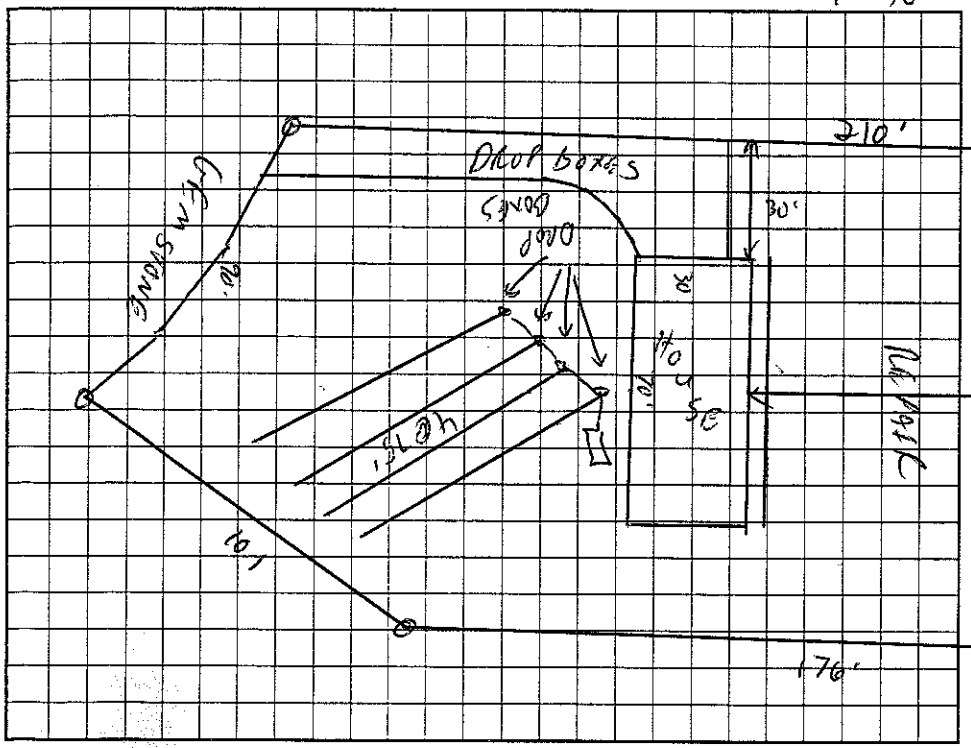

AS BUILT SKETCH

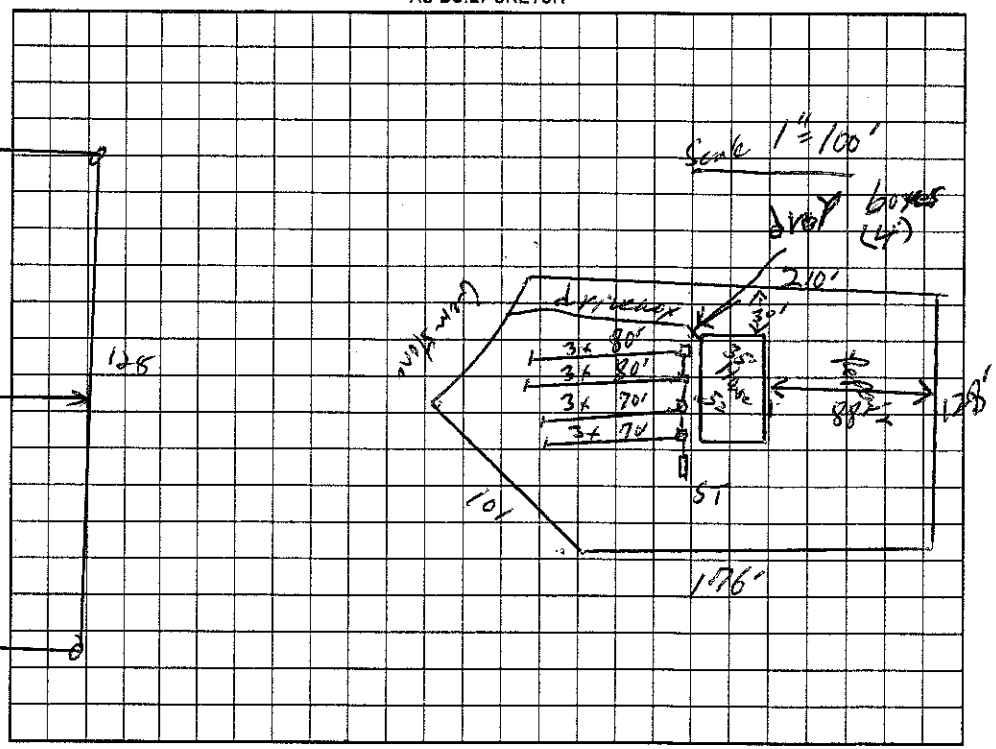

Permit can be suspended or revoked if any false information is supplied toward securing the permit/any unauthorized changes are made to the site/any unauthorized changes are made in the installation of the system. Improvement Permit with plat valid without expiration. Improvement Permit with site plan valid for sixty months. Authorization to Construct is valid for a period equal to that of Improvement Permit – not to exceed sixty months.

Signed: Steve Epps date 1-18-02 Installed by: A-1 Backhoe

Improvement Permit by: KS date 1/15/02 Operation Permit by: Bill Johnson date 2/3/03

Authorization to Construct by: William A. Johnson date 1/29/03 Existing System Inspection by: date

HEALTH DEPT. COPY: WHITE OWNER COPY (FINAL): YELLOW OWNER COPY (INITIAL): PINK