IREDELL COUNTY HEALTH DEPARTMENT

STATESVILLE 704-878-5305 / 25.00 Paid MOORESVILLE 704-664-5281

IMPROVEMENT PERMIT / AUTHORIZATION TO CONSTRUCT / OPERATION PERMIT / EXISTING SYSTEM INSPECTION

PERMIT# 104081 PIN# 4705 76 8328 DATE 1/15/02

OWNER OR CONTRACTOR JOHNNY CRAVER PHONE: Business 663 - 2220 Home

ADDRESS 130 LAZY LANE MOORESVILLE 28117

LOCATION 64N - TL LEOPARD FARM - TL STONES EDGE - TL GEMSTONE ON LT

SUBDIVISION STONESEDGE BLOCK / SECTION LOT 8 LOT AREA 1.54AC SITE CLASS PS DESIGN FLOW 360GPD L.T.A.R. .3010/Kro

Septic Tank: 1000 Gallons: STB 1012 Date 12-9-01
Pump Tank: 1000 Gallons; PT 17 Date 2-20-01
Pump Make: MYERS Model MW50-11P Serial No 2608BD501
Nitrification Field: No Fields 1 Square Feet 900 Linear Feet 300
No Lines 5 @ 60' Trench Width 36" Max Trench Bottom Depth 36" Gravel Depth NA

☒ New System ☐ Repair System Type: I. II (III) IV. V. VI
System Description: PUMP 25% REDUCTION
Repair System Description: UP PANEL
Maintenance Agreement Required: ☐ Yes ☒ No
☐ Slab ☐ Crawl Space ☐ Basement w/plumbing ☐ Basement wo/plumbing


☒ House/Mod. Home ☐ Mobile Home ☐ Business ☐ Other
No. Bedrooms 3 No. Bathrooms 3 No. Employees

Water Supply: ☐ Individual ☒ Public ☐ Community

Comments/Conditions:

Comments/Conditions: POLYLOK FILTER & MARKER
V'ID LINES & PRESSURE

INITIAL SITE SKETCH 1"=50'

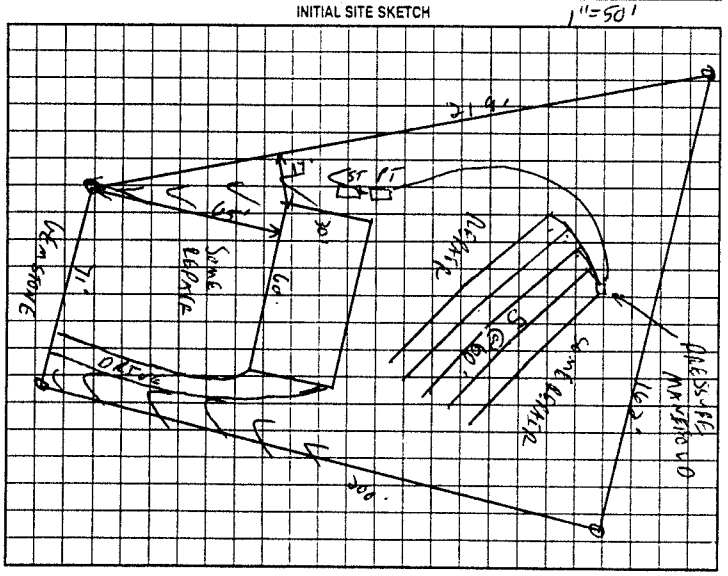

AS BUILT SKETCH

NEED TO ✓ PUMP FLOAT TREE & ELECTRICAL
(CC) ✓
- Float Tree, Electrical & Alarm Checked 5-8-02 ✓

Installed as Shown per Initial Site Sketch

Permit can be suspended or revoked if any false information is supplied toward securing the permit/any unauthorized changes are made to the site/any unauthorized changes are made in the installation of the system. Improvement Permit with plat valid without expiration. Improvement Permit with site plan valid for sixty months. Authorization to Construct is valid for a period equal to that of Improvement Permit - not to exceed sixty months

Signed: Steve Hyo date 1-18-02 Installed by: A-1 Backhoe

Improvement Permit by: C. [illegible] RS date 1/15/02 Operation Permit by: William O. Johnson date 5/8/02

Authorization to Construct by: William O. Johnson date 4/12/02 Existing System Inspection by: date

HEALTH DEPT. COPY: WHITE OWNER COPY (FINAL): YELLOW OWNER COPY (INITIAL): PINK