IREDELL COUNTY HEALTH DEPARTMENT

STATESVILLE 704-878-5305 MOORESVILLE 704-664-5281

IMPROVEMENT PERMIT / AUTHORIZATION TO CONSTRUCT / OPERATION PERMIT / EXISTING SYSTEM INSPECTION

PERMIT# 076982 PIN# 4705 78 7803 DATE 10-24-98

OWNER OR CONTRACTOR C. CAMPBELL / PILKINGTON PHONE: Business Home 873-6838

ADDRESS 732 LIPPARD FARM ROAD, STATESVILLE NC 28625

LOCATION US 64 WEST, TR LIPPARD FARM ROAD, TR JUST PAST BOX # 732

SUBDIVISION BLOCK / SECTION LOT LOT AREA 1.20 ACRE SITE CLASS. PS DESIGN FLOW 360 L.T.A.R. 0.30 GPD/FT²

Septic Tank: 1000 Gallons; STB 1007 Date 12-17-98
Pump Tank: Gallons; PT Date
Pump Make: Model Serial No.
Nitrification Field: No Fields 1 Square Feet 1200 Linear Feet 300'
No Lines THREE Trench Width 36" Max Trench Bottom Depth 36" Depth 6"

☑ New System ☐ Repair System Type: I, II, III, IV, V, VI
System Description: 25% REDUCTION GRAVITY
Repair System Description: 25% REDUCTION PUMP
Maintenance Agreement Required: ☐ Yes ☑ No
☐ Slab ☐ Crawl Space ☑ Basement w/plumbing ☐ Basement wo/plumbing

☑ House/Mod. Home No. Bedrooms 3
☐ Mobile Home No. Bathrooms 2
☐ Business No. Employees
☐ Other


Water Supply: ☐ Individual ☑ Public ☐ Community

Comments:/Conditions: INSTALL 25% REDUCTION SYSTEM USING FIFTY 6' CHAMBERS OR THIRTY H.D.S. SECTIONS

Comments:/Conditions:

SCALE: 1" = 60'

INITIAL SITE SKETCH

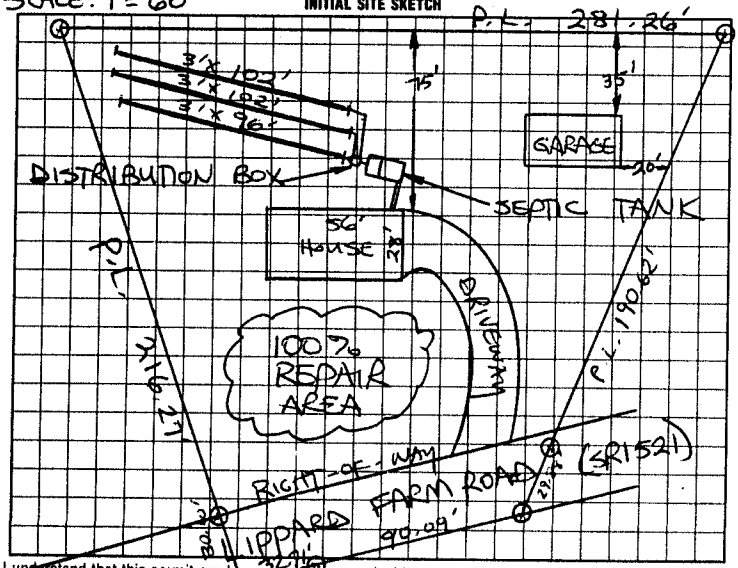

AS BUILT SKETCH

SYSTEM INSTALLED ACCORDING TO INITIAL SITE SKETCH

I understand that this permit can be suspended or revoked if any false information is supplied toward securing the permit/any unauthorized changes are made to the site/any unauthorized changes are made in the installation of the system. Improvement Permit with plat valid without expiration. Improvement Permit with site plan valid for sixty months. Authorization to Construct is valid for a period equal to that of Improvement Permit – not to exceed sixty months.

Signed: Carolyn P. Campbell date 10-30-98 Installed by: TOMMY COTNREN

Improvement Permit by: STEVE HEDRICK date 10-24-98 Operation Permit by: STEVE HEDRICK date 3-18-99

Authorization to Construct by: STEVE HEDRICK date 10-24-98 Existing System Inspection by: date

HEALTH DEPT. COPY: WHITE INSPECTION COPY (FINAL): GREEN OWNER COPY (FINAL): YELLOW INSPECTION COPY (INITIAL): PINK OWNER COPY (INITIAL): GOLD