# IREDELL COUNTY HEALTH DEPARTMENT

STATESVILLE 704-878-5305 MOORESVILLE 704-664-5281

## IMPROVEMENT PERMIT / AUTHORIZATION TO CONSTRUCT / OPERATION PERMIT / EXISTING SYSTEM INSPECTION

PERMIT# REPAIR PIN# 4705-79-2023 DATE 5-4-05

OWNER OR CONTRACTOR ANDREW C. DERISO PHONE: Business Home 704.873-0166

ADDRESS 128 DAISEY BARE LANE, STATESVILLE, NC 28625-1861

LOCATION US64 WEST, TR LIPPARD FARM RD, TL PROUST ROAD, TR DAISEY BARE LANE, 1ST HOUSE ON RIGHT

SUBDIVISION BLOCK / SECTION LOT LOT AREA 0.62 ACRE SITE CLASS PS DESIGN FLOW 360 L.T.A.R. EXISTING 0.3

Septic Tank: EXISTING Gallons; STB Date

Pump Tank: Gallons; PT Date

Pump Make: Model Serial No.

Nitrification Field: No Fields 1 Square Feet 360 Linear Feet 120

No Lines TWO Trench Width 36" Max Trench Bottom Depth 48"

☐ New System ☑ Repair System Type: I (II) III, IV, V, VI

System Description:

Repair System Description: CONVENTIONAL, GRAVITY

Maintenance Agreement Required: ☐ Yes ☑ No

Gravel Depth SAND 24"/12"

☑ House/Mod. Home No. Bedrooms 3

☐ Mobile Home No. Bathrooms

☐ Business No. Employees

☐ Other


☐ Slab ☐ Crawl Space ☑ Basement w/plumbing ☐ Basement wo/plumbing

Water Supply: ☐ Individual ☑ Public ☐ Community

Comments:/Conditions: ① LOCATE UTILITIES (UNDERGROUND POWER) ② INSTALL SAND-LINED TRENCHES USING 24" SAND (PACKED) WITH 12" STONE ON TOP W/ CORRUGATED DRAIN LINE (.1948 (d)) ③ INSTALL NEW SANITARY TEE IN TANK.

Comments:/Conditions:

INITIAL SITE SKETCH ~ SCALE: 1"=40'

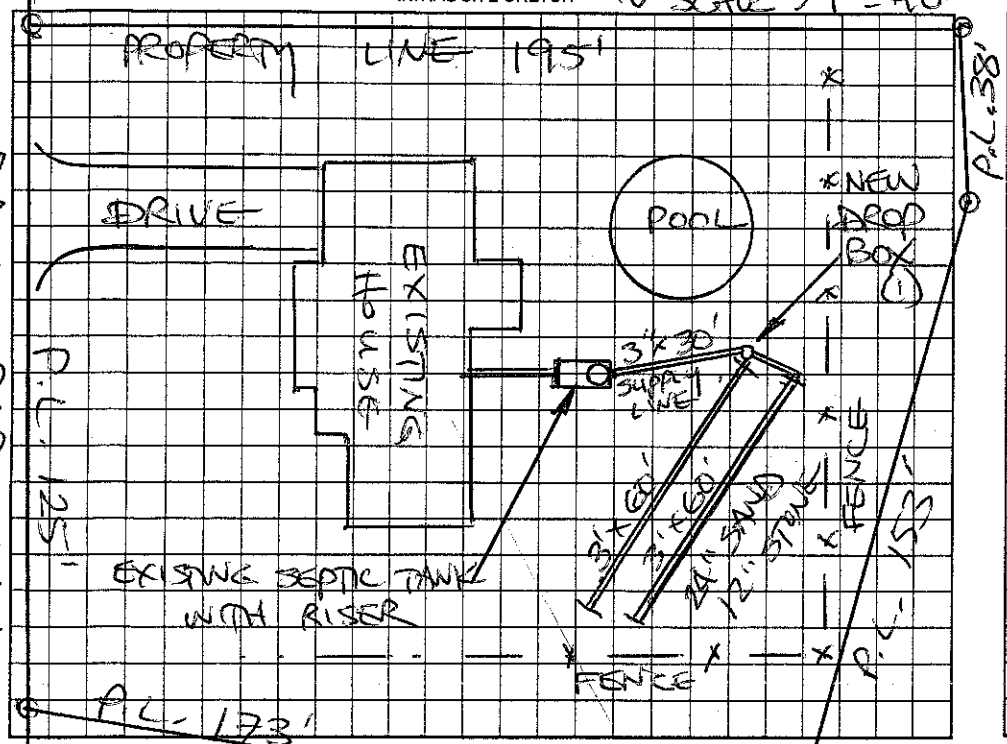


AS BUILT SKETCH

SYSTEM REPAIRED ACCORDING TO INITAL SITE SKETCH

Permit can be suspended or revoked if any false information is supplied toward securing the permit/any unauthorized changes are made to the site/any unauthorized changes are made in the installation of the system. Improvement Permit with plat valid without expiration. Improvement Permit with site plan valid for sixty months. Authorization to Construct is valid for a period equal to that of Improvement Permit – not to exceed sixty months.

Signed: x Andrew C DeRiso date 5-4-05 Installed by: PIEDMONT BACKHOE

Improvement Permit by: STEVE HEDRICK date 5-4-05 Operation Permit by: STEVE HEDRICK date 5-11-05

Authorization to Construct by: STEVE HEDRICK date 5-4-05 Existing System Inspection by: date

HEALTH DEPT. COPY: WHITE OWNER COPY (FINAL): YELLOW OWNER COPY (INITIAL): PINK