IREDELL COUNTY HEALTH DEPARTMENT

Statesville Phone TR 3-7271 Mooresville Phone NO 3-1271

PERMIT TO INSTALL SEPTIC TANK

Permit NO. _____ Permit Date AUG 1, 1959

Owner THELMA SUMMERS Address _____

Installed By HOKE Address _____


Location of Property HP #90 LEFT AT DON MURDOCKS SERVICE STATION 1st BRICK-O-RIGHT.

Tank		Capacity		Length of Lines		Fixtures	
Block	( )	800	(✓)	150'	(✓)	No. of Baths	(1)
Precast	(✓)	900	( )	175'	( )	Dishwasher	( )
		1000	( )	200'	( )	Garbage Grdr.	( )
		1100	( )	225'	( )	Auto-Washer	( )
		1200	( )	250'	( )	Other _____	
		Other _____		Other _____			

NOTIFY HEALTH DEPARTMENT AT LEAST EIGHT HOURS BEFORE TANK IS TO BE INSPECTED.

Final Inspection AUG 1, 1959 Approved (✓) Disapproved ( )

Remarks DRIVE

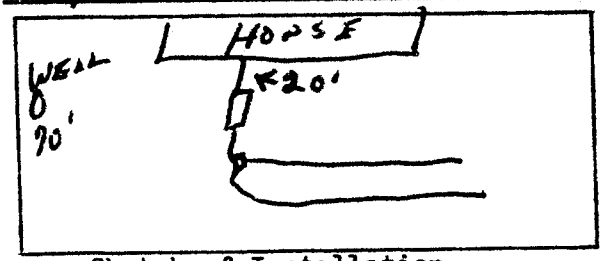

Sketch of Installation

Raford G. Hoke

Sanitarian