IREDELL COUNTY HEALTH DEPARTMENT

STATESVILLE 704-878-5305 MOORESVILLE 704-664-5281 (1)

IMPROVEMENT PERMIT / AUTHORIZATION TO CONSTRUCT / OPERATION PERMIT / EXISTING SYSTEM INSPECTION

PERMIT# 119215 PIN# 4705-79-6006 DATE 3-19-09

OWNER OR CONTRACTOR ALISHA PRESNELL PHONE: Business 704-873-5706 Home 704-880-7060

ADDRESS 147 RAINTREE PARK ROAD, HIDDENITE, NC 28636

LOCATION US 64 WEST TR LIPPARDS FARM RD 1ST DRIVE ON LEFT PAST PROUST ROAD

SUBDIVISION _____ BLOCK / SECTION _____ LOT _____ LOT AREA 2.4 ACRES SITE CLASS. PS DESIGN FLOW 360 L.T.A.R. 0.5 GPD/FT/EXISTING

Septic Tank: 1000 Gallons; STB _____ Date _____

Pump Tank: _____ Gallons; PT _____ Date _____

Pump Make: _____ Model _____ Serial No. _____

Nitrification Field: No Fields 1 Square Feet 720 Linear Feet 240

No Lines THREE Trench Width 36" Max Trench Bottom Depth DEEP>48" Gravel Depth 12"

☐ New System ☐ Repair System Type: I, II, III, IV, V, VI

System Description: CONVENTIONAL, GRAVITY

Repair System Description: _____

Maintenance Agreement Required: ☐ Yes ☒ No

☐ House/Mod. Home ☒ Mobile Home ☐ Business ☐ Other

No. Bedrooms 3 No. Bathrooms 2 No. Employees ____

☐ Slab ☑ Crawl Space ☐ Basement w/plumbing ☐ Basement wo/plumbing


Water Supply: ☐ Individual ☒ Public ☐ Community

Comments:/Conditions:

Comments:/Conditions: SYSTEM UNDERSIZED ACCORDING TO TODAY'S STANDARDS

INITIAL SITE SKETCH

AS BUILT SKETCH

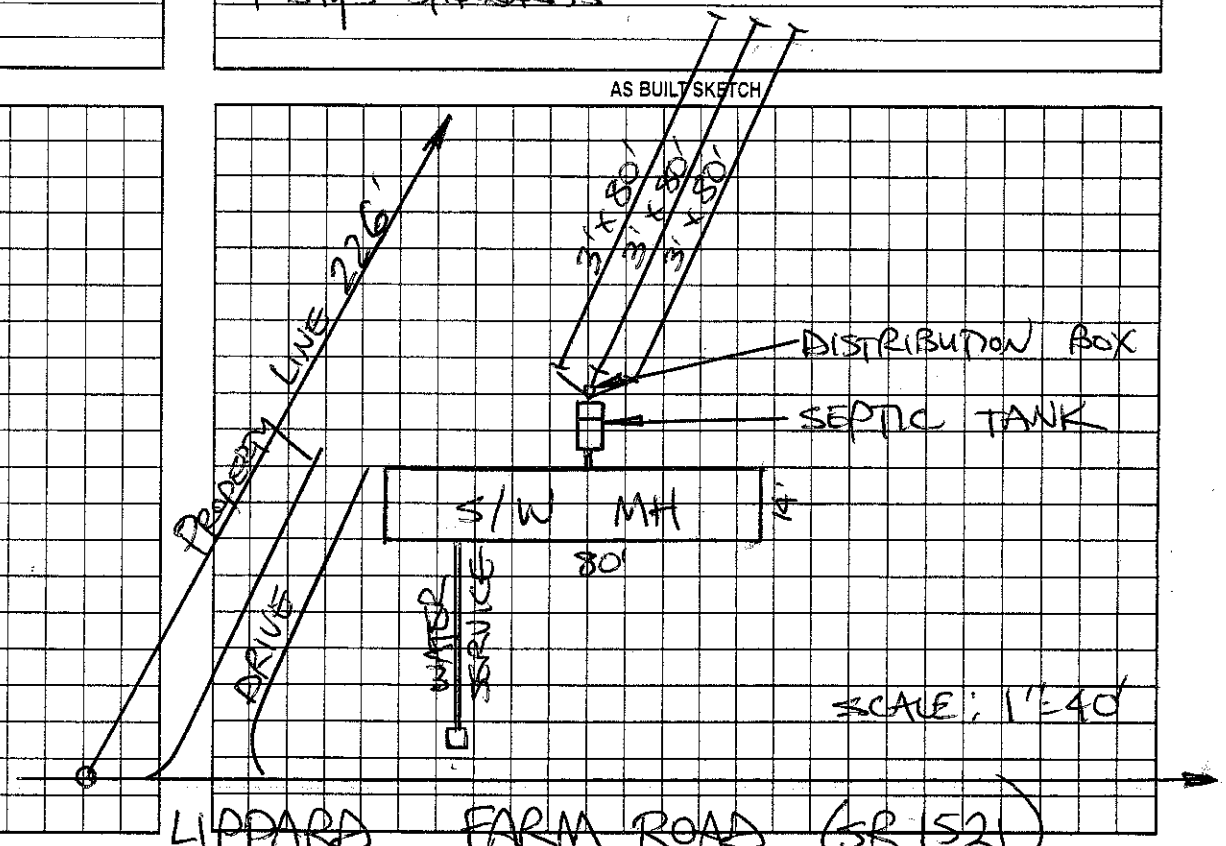

Permit can be suspended or revoked if any false information is supplied toward securing the permit/any unauthorized changes are made to the site/any unauthorized changes are made in the installation of the system. Improvement Permit with plat valid without expiration. Improvement Permit with site plan valid for sixty months. Authorization to Construct is valid for a period equal to that of Improvement Permit – not to exceed sixty months.

Signed: _____ date _____ Installed by: _____

Improvement Permit by: _____ date _____ Operation Permit by: _____ date _____

Authorization to Construct by: _____ date _____ Existing System Inspection by: STEVE HEDRICK date 3-19-09

HEALTH DEPT. COPY: WHITE OWNER COPY (FINAL): YELLOW OWNER COPY (INITIAL): PINK