IREDELL COUNTY HEALTH DEPARTMENT

Statesville Phone TR 3-7271 Mooresville Phone NO 3-1271

PERMIT TO INSTALL SEPTIC TANK

Permit NO. _____ Permit Date Nov 18 1958

Owner Dare Pritchard #2 Address Taylo Rd.

Installed By C Hoke Address R 7

Location of Property 3rd house on left above Don Murdock Amoco Sta. new brick


Tank		Capacity		Length of Lines		Fixtures	
Block	( )	800	(4)	150'	(4)	No. of Baths	( )
Precast	(4)	900	( )	175'	( )	Dishwasher	( )
		1000	( )	200'	( )	Garbage Grdr.	( )
		1100	( )	225'	( )	Auto-Washer	( )
		1200	( )	250'	( )	Other	
		Other		Other			

NOTIFY HEALTH DEPARTMENT AT LEAST EIGHT HOURS BEFORE TANK IS TO BE INSPECTED.

Final Inspection Nov 18 1958 Approved ( ) Disapproved ( )

Remarks water from central well -

Per JE Hoke

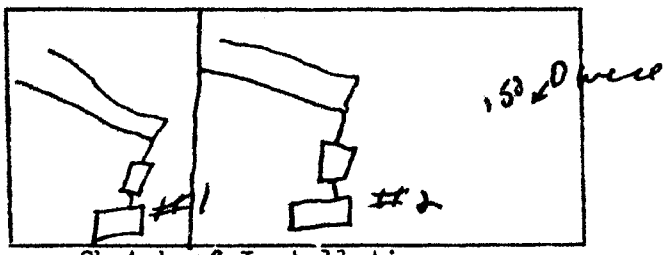

Sketch of Installation

R. G. L

Sanitarian