066624

IREDELL COUNTY HEALTH DEPARTMENT

STATESVILLE 704-878-5305 MOORESVILLE 704-664-5281

IMPROVEMENT PERMIT / CERTIFICATE OF COMPLETION / OPERATION PERMIT / EXISTING SYSTEM INSPECTION

PROPERTY DESCRIPTION NO. ~~23191 23151~~ DATE 4-17-97 TAX MAP NO. 8T-A-81/82 Watershed: ☐ Yes ☒ No

OWNER OR CONTRACTOR Leon Gray PHONE: Business 872-2081 Home

ADDRESS 202N Shelton Ln Sta

LOCATION US 64 W TL Hippark Farm Rd TL Massey Real TL Excel 1st Lot Rt

SUBDIVISION Forest Meadows BLOCK / SECTION LOT 1 LOT AREA ~~1.67~~ 1.7 acres SITE CLASS PS DESIGN FLOW 360 L.T.A.R. .137

Septic Tank: 1000 Gallons; STB 1012 Date 3-11-97

Pump Tank: Gallons; PT Date

Pump Make: Model Serial No.

Nitrification Field: No Fields 1 Square Feet 1140 Linear Feet 380

No Lines 4 Trench Width 36" Max Trench Bottom Depth 36" Gravel Depth 12"

☒ New System ☐ Repair System Type: I, II, III, IV, V, VI

System Description: Conv. Gravity

Repair System Description: " "

Maintenance Agreement Required: ☐ Yes ☒ No

☐ House/Mod. Home No. Bedrooms 3

☐ Mobile Home No. Bathrooms 2

☐ Business No. Employees

☐ Other


☐ Slab ☒ Crawl Space ☐ Basement w/plumbing ☐ Basement wo/plumbing

Water Supply: ☐ Individual ☐ Community ☒ Public


Comments:

Comments:

INITIAL SITE SKETCH

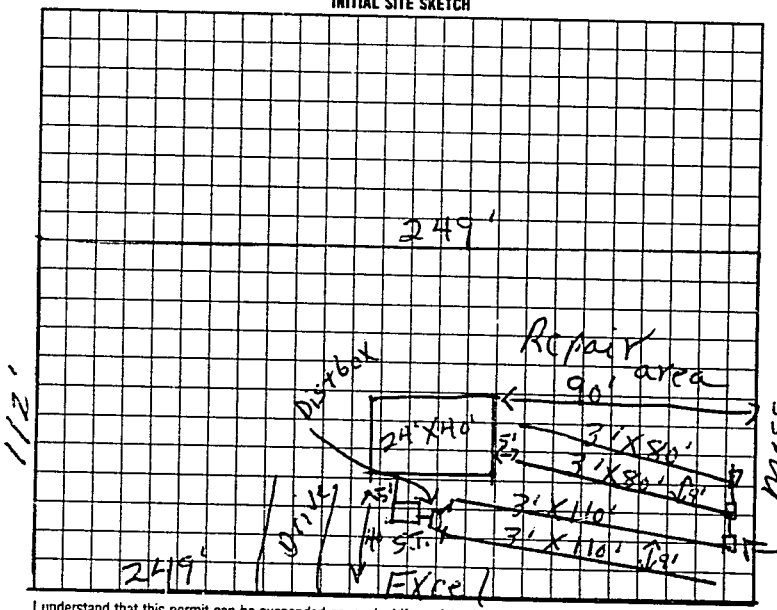

AS BUILT SKETCH

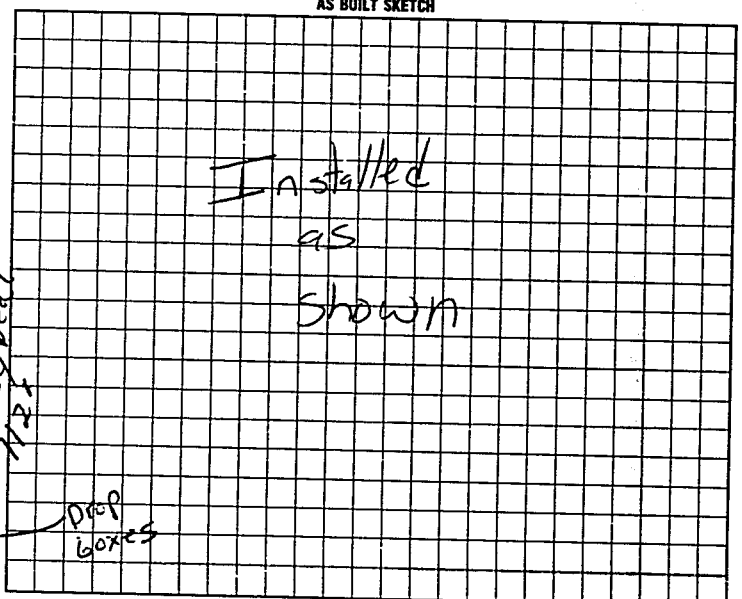

I understand that this permit can be suspended or revoked if any false information is supplied toward securing the permit/any unauthorized changes are made to the site/any unauthorized changes are made in the installation of the system. Improvement Permit is valid for 60 months from date of issuance.

Signed: X Leon Gray Tyler Sorsa Robbins

Improvement Permit by: P.C. Moore date 4-17-97

Authorization to Construct

Existing System Inspection by: P.C. Moore date 4-17-97

Installed by: Dale Fox

Certificate of Completion by: date

Operation Permit by: Mary C Ott RS date 5-14-97

HEALTH DEPT. COPY: WHITE INSPECTION COPY (FINAL): GREEN OWNER COPY (FINAL): YELLOW INSPECTION COPY (INITIAL): PINK OWNER COPY (INITIAL): GOLD

authorization to Const. Expires 60 mos from issue

Y L 2 0 0 0