IREDELL COUNTY HEALTH DEPARTMENT

STATESVILLE 704-878-5305 55.00 Paid MOORESVILLE 704-664-5281

IMPROVEMENT PERMIT / AUTHORIZATION TO CONSTRUCT / OPERATION PERMIT / EXISTING SYSTEM INSPECTI

PERMIT# 102620 PIN# 4705855934.29 DATE 7/12/02

OWNER OR CONTRACTOR Johnny Craver PHONE: Business 663 2220 Home

ADDRESS 130 Lazy Lane Mooresville

LOCATION 64W - TL Lippard Farm - TL Stonegedge - TL Gemstone - TR Zircon - 3rd on LT

SUBDIVISION Stonegedge BLOCK / SECTION LOT 29 LOT AREA .619 AC SITE CLASS RS DESIGN FLOW 360GPD L.T.A.R. .250 PD/FT2

Septic Tank: 1000 Gallons: STB 1012 Date 3-20-02
Pump Tank: Gallons: PT Date
Pump Make: Model Serial No.
Nitrification Field: No Fields 1 Square Feet 1080 Linear Feet 360
No Lines 5@72' Trench Width 36" Max Trench Bottom Depth 36"

☑ New System ☐ Repair System Type: I II (III) IV V VI
System Description: Gravity 25% Reduction
Repair System Description: LP Panel
Maintenance Agreement Required: ☐ Yes ☑ No
Gravel Depth N/A ☐ Slab ☑ Crawl Space ☐ Basement w/plumbing ☐ Basement wo/plumbing


☑ House/Mod. Home No Bedrooms 3
☐ Mobile Home No. Bathrooms 3
☐ Business No Employees
☐ Other

Water Supply: ☐ Individual ☑ Public ☐ Community


Comments:/Conditions:

Comments:/Conditions:
- Poly Lok Filter & Septic Tank Marker Installed
- 60 Infiltrator Chamber Installed

INITIAL SITE SKETCH 1"=50'

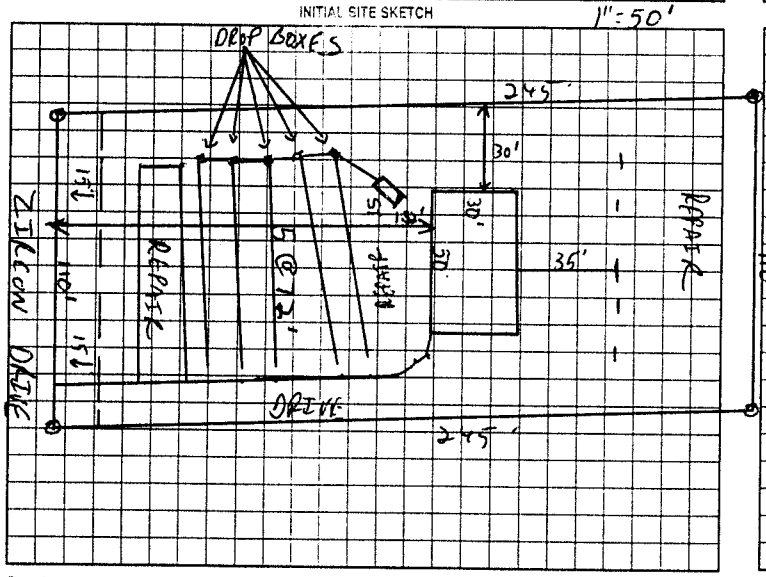

AS BUILT SKETCH

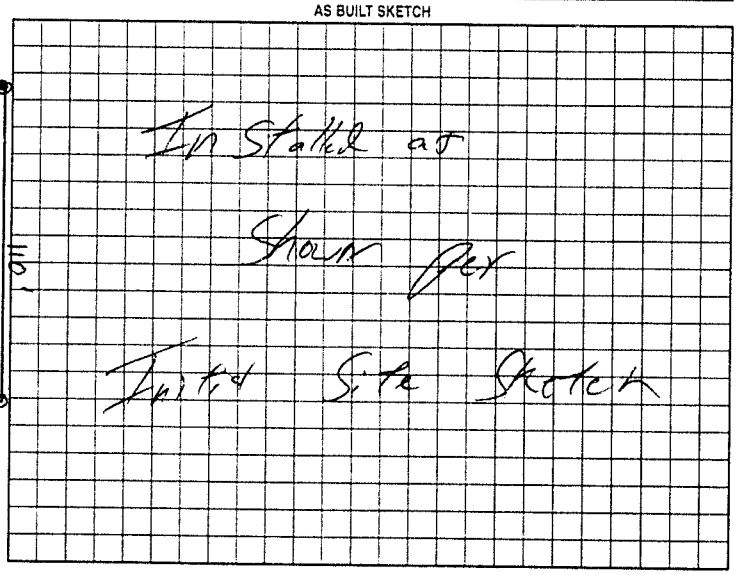

Permit can be suspended or revoked if any false information is supplied toward securing the permit/any unauthorized changes are made to the site/any unauthorized changes are made in the installation of the system. Improvement Permit with plat valid without expiration. Improvement Permit with site plan valid for sixty months. Authorization to Construct is valid for a period equal to that of Improvement Permit – not to exceed sixty months.

Signed: date 2-16-02 Installed by: Craig Thompson

Improvement Permit by: RS date 7/12/02 Operation Permit by: William O. Johnson date

Authorization to Construct by: RS date 7/12/02 Existing System Inspection by: date

HEALTH DEPT COPY WHITE OWNER COPY (FINAL) YELLOW OWNER COPY (INITIAL) PINK