IREDELL COUNTY HEALTH DEPARTMENT

STATESVILLE 704-878-5305 $55.00 Paid MOORESVILLE 704-664-5281

IMPROVEMENT PERMIT / AUTHORIZATION TO CONSTRUCT / OPERATION PERMIT / EXISTING SYSTEM INSPECTI

PERMIT# 102-620 PIN# 4705858934.29 DATE 7/10/02

OWNER OR CONTRACTOR Mr. JOHNNY CRAVER PHONE: Business 663-2220 Home

ADDRESS 130 LAZY LANE MOORESVILLE

LOCATION 64W - TL LIPPARD FARM - TL STONEGEDGE - TL GEMSTONE - TR ZIRCON - 3RD ON LT

SUBDIVISION STONEGEDGE BLOCK / SECTION LOT 29 LOT AREA .619 AC SITE CLASS RS DESIGN FLOW 360GPD L.T.A.R. 250 SQ FEET

Septic Tank: 1000 Gallons: STB 1012 Date 3-10-02
Pump Tank: Gallons; PT Date
Pump Make: Model Serial No.
Nitrification Field: No Fields 1 Square Feet 1080 Linear Feet 360
No Lines SEE Trench Width 36" Max Trench Bottom Depth 36" Gravel Depth N/A

☑ New System ☐ Repair System Type: I, II, (III), IV, V, VI
System Description: GRAVITY 25% REDUCTION
Repair System Description: LP PANEL
Maintenance Agreement Required: ☐ Yes ☑ No
☐ Slab ☑ Crawl Space ☐ Basement w/plumbing ☐ Basement wo/plumbing


☑ House/Mod. Home ☐ Mobile Home ☐ Business ☐ Other
No. Bedrooms 3 No. Bathrooms 3 No. Employees

Water Supply: ☐ Individual ☑ Public ☐ Community


Comments/Conditions:

Comments/Conditions:
Poly Pak Fitter + Septic Tank Marker Installed
60 Infiltrator Chamber Installed

INITIAL SITE SKETCH 1"=50'

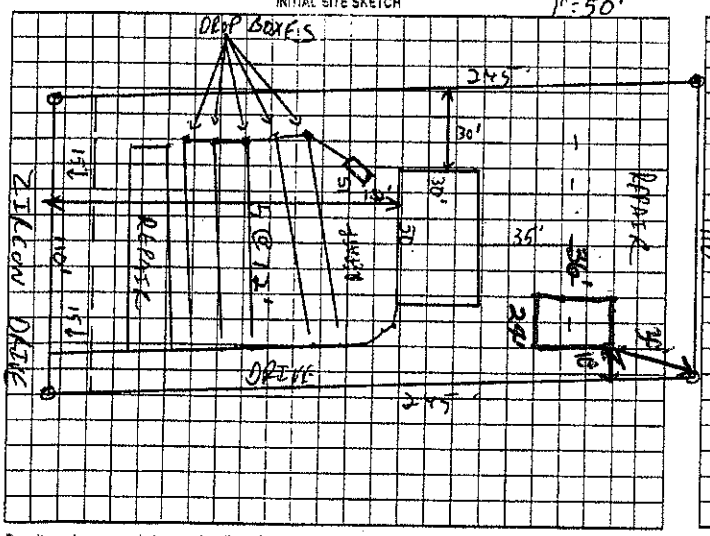

AS BUILT SKETCH

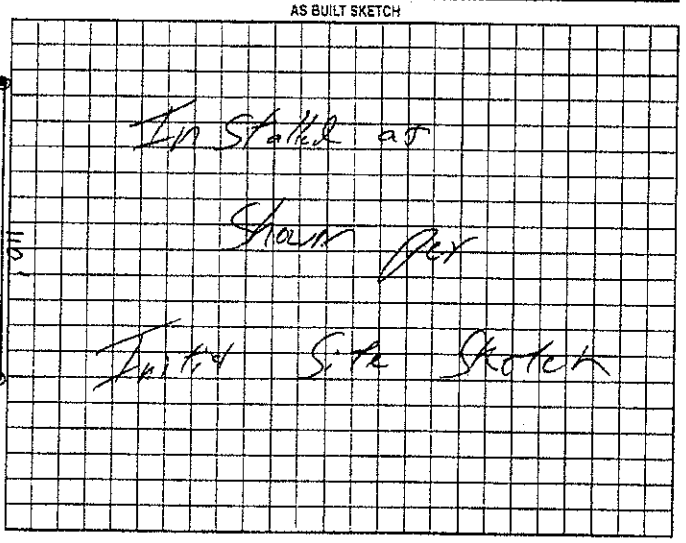

Permit can be suspended or revoked if any false information is supplied toward securing the permit/any unauthorized changes are made to the siteany unauthorized changes are made in the installation of the system. Improvement Permit with plat valid without expiration. Improvement Permit with site plan valid for sixty months. Authorization to Construct is valid for a period equal to that of Improvement Permit – not to exceed sixty months.

Signed: date 7-16-02 Installed by: Craig Thompson

Improvement Permit by: RS date 7/10/02 Operation Permit by: date

Authorization to Construct by: RS date 7/10/02 Existing System Inspection by: date

HEALTH DEPT. COPY WHITE OWNER COPY (FINAL) YELLOW OWNER COPY (INITIAL) PINK

Location of the proposed Shed addition does not appear to impact the existing on-site septic system.**NOTE:

Justin Henderson REHS

Date: 7-11-12

ICHD-Environmental Health Division