owner's Connie Sue BALLARD

IREDELL COUNTY HEALTH DEPARTMENT

STATESVILLE 704-878-5305 (C) 130,00 +2.9 MOORESVILLE 704-664-5281

IMPROVEMENT PERMIT / AUTHORIZATION TO CONSTRUCT / OPERATION PERMIT / EXISTING SYSTEM INSPECTION

PERMIT# 108435 PIN# 4705-55-259.3 DATE 9/17/04

OWNER OR CONTRACTOR STONES EDGE INC PHONE: Business 663-2220 Home

ADDRESS 130 LAZY LANE MOORESVILLE NC 28117

LOCATION 64 WEST - TL LEPPARD FARM - TL STONES EDGE - TL GEMSTONE - TR ZIRCON - ON RT.

SUBDIVISION STONES EDGE BLOCK / SECTION LOT 103 LOT AREA .517 AC SITE CLASS. PS DESIGN FLOW 360GPD L.T.A.R. .3640/FT

Septic Tank: 1000 Gallons; STB 1012 Date 5-15-04

Pump Tank: Gallons; PT Date

Pump Make: Model Serial No.

Nitrification Field: No Fields 1 Square Feet 900 Linear Feet 300

No Lines 4@75' Trench Width 36" Max Trench Bottom Depth 36" Gravel Depth N/A

☑ New System ☐ Repair System Type: I, II, (III), IV, V, VI

System Description: GRAVITY 25% REDUCTION

Repair System Description: SAME

Maintenance Agreement Required: ☐ Yes ☑ No

☑ House/Mod. Home No. Bedrooms 3

☐ Mobile Home No. Bathrooms 2

☐ Business No. Employees

☐ Other


☐ Slab ☑ Crawl Space ☐ Basement w/plumbing ☐ Basement wo/plumbing

Water Supply: ☑ Individual ☑ Public ☐ Community

Comments/Conditions:

Comments/Conditions: SEPTIC TANK WITH MARKER INSTALLED USING "TUFFTITE" FILTER

INITIAL SITE SKETCH 1"=50'

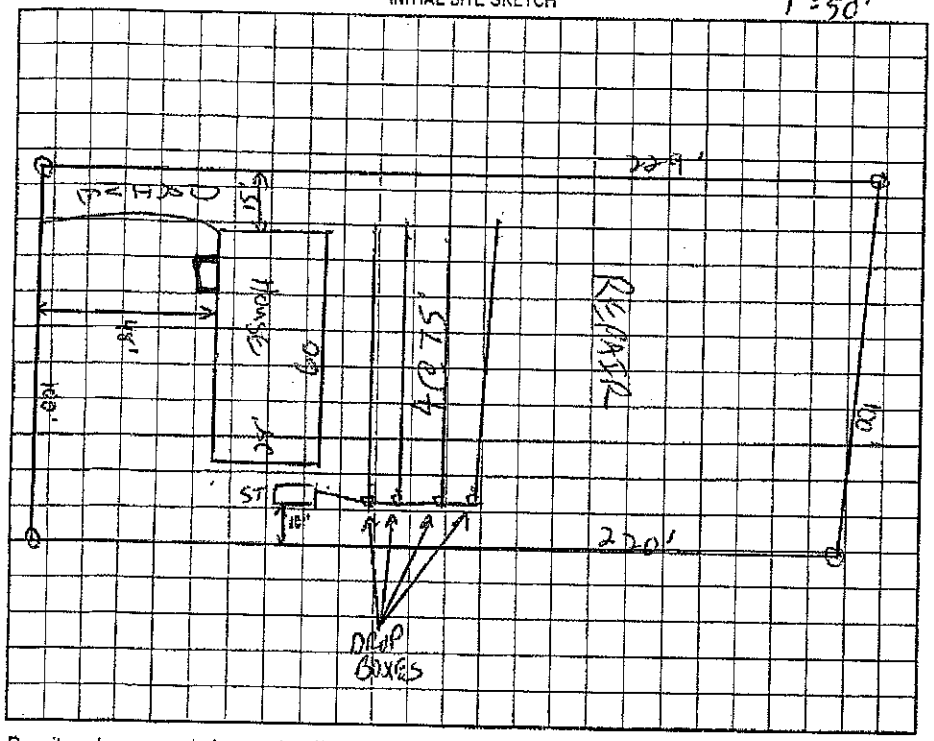

AS BUILT SKETCH

SYSTEM INSTALLED ACCORDING TO INITIAL SITE SKETCH USING 48" "INFILTRATOR" CHAMBERS

Location of the proposed handicapped Ramp addition does not appear to impact the existing on-site septic system.**NOTE:

REHS

Date: 9-13-12

ICHD-Environmental Health Division

Permit can be suspended or revoked if any false information is supplied toward securing the permit/any unauthorized changes are made to the site/any unauthorized changes are made in the installation of the system. Improvement Permit with plat valid without expiration. Improvement Permit with site plan valid for sixty months. Authorization to Construct is valid for a period equal to that of Improvement Permit – not to exceed sixty months.

Signed: Jerri Johnston date 9-17-04

Improvement Permit by: C. Hyatt HS date 9/17/04

Authorization to Construct by: C. Hyatt HS date 9/17/04

Installed by: A-1 BACKHOE

Operation Permit by: STEVE HERRICK date 10-12-04

Existing System Inspection by: date

HEALTH DEPT. COPY: WHITE OWNER COPY (FINAL): YELLOW OWNER COPY (INITIAL): PINK