IREDELL COUNTY HEALTH DEPARTMENT

STATESVILLE 704-878-5305 130.00 Paid MOORESVILLE 704-664-5281

IMPROVEMENT PERMIT / AUTHORIZATION TO CONSTRUCT / OPERATION PERMIT / EXISTING SYSTEM INSPECTION

PERMIT# 105286 PIN# 4705 85 5550 DATE 12/27/02

OWNER OR CONTRACTOR STONES EDGE INC PHONE: Business 663-2220 Home

ADDRESS 130 LAZY LANE

LOCATION 64(W) - TL LIPPARD FARM - TL STONES EDGE - TR ZIRCON - ~~TL FERGUT~~ ON ~~RT~~ RT

SUBDIVISION STONES EDGE BLOCK / SECTION LOT 101 LOT AREA 1.107 ac SITE CLASS. PS DESIGN FLOW 4 BDRMS @ 360 GPD L.T.A.R. .3650 GPD

Septic Tank: 1000 Gallons; STB 1-10-02 Date 1002

Pump Tank: 1000 Gallons; PT 11-7-02 Date 1007

Pump Make: Cowles Model WE05111HH Serial No. 503690242

Nitrification Field: No Fields 1 Square Feet 1200 Linear Feet 400

No Lines 5 @ 80' Trench Width 36" Max Trench Bottom Depth 24"

☑ New System ☐ Repair System Type: I, II, III, IV, V, VI

System Description: Pump 25% Reduction

Repair System Description: LPP

Maintenance Agreement Required: ☐ Yes ☑ No

Gravel Depth N/A

☐ Slab ☑ Crawl Space ☐ Basement w/plumbing ☐ Basement wo/plumbing

☑ House/Mod. Home No. Bedrooms 4

☑ Mobile Home No. Bathrooms 4

☐ Business No. Employees


☐ Other

Water Supply: ☐ Individual ☑ Public ☐ Community

Comments/Conditions:

1" = 50'

INITIAL SITE SKETCH

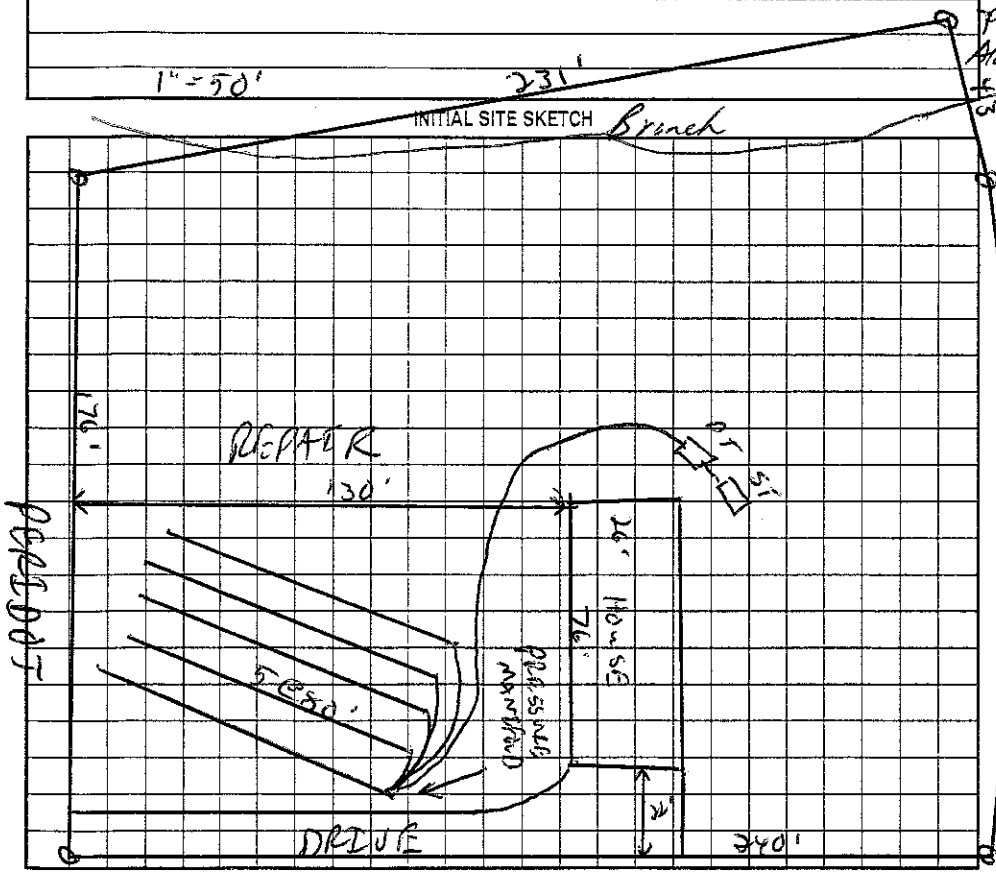


Comments/Conditions: HO gave prior approval to move driveway, will W/O/C

Pressure Check Two Site Filter, Lines Checked Okay

Alarm + Electrical ST Inside Installed

+ Okay - 2/18/03

AS BUILT SKETCH

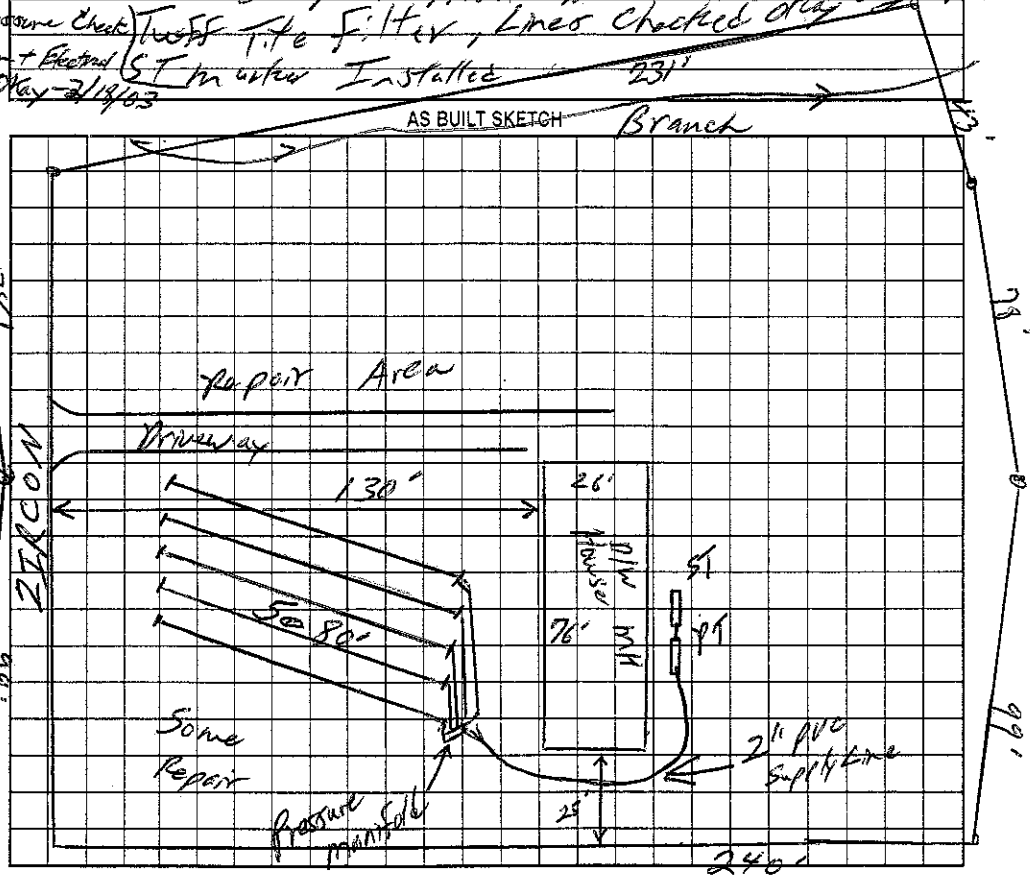

Permit can be suspended or revoked if any false information is supplied toward securing the permit/any unauthorized changes are made to the site/any unauthorized changes are made in the installation of the system. Improvement Permit with plat valid without expiration. Improvement Permit with site plan valid for sixty months. Authorization to Construct is valid for a period equal to that of Improvement Permit – not to exceed sixty months.

Signed: [signature] date 1/3/03 Installed by: A-1 Backhoe

Improvement Permit by: [signature] CS date 12/27/02 Operation Permit by: William O. Johnson date 2/18/03

Authorization to Construct by: [signature] CS date 12/27/02 Existing System Inspection by: date

HEALTH DEPT. COPY: WHITE OWNER COPY (FINAL): YELLOW OWNER COPY (INITIAL): PINK