IREDELL COUNTY HEALTH DEPARTMENT

STATESVILLE 704-878-5305 155.00 Paid MOORESVILLE 704-664-5281

IMPROVEMENT PERMIT / AUTHORIZATION TO CONSTRUCT / OPERATION PERMIT / EXISTING SYSTEM INSPECTION

PERMIT# 104619 PIN# 4705-858257 DATE 4/10/02

OWNER OR CONTRACTOR STONES EDGE PHONE: Business 663-2220 Home

ADDRESS 130 LAZY LANE MOORESVILLE

LOCATION 64W - TL LIPPARD FARM - TL STONES EDGE - TL GEMSTONE - TR ZIRCON - ON RT

SUBDIVISION STONES EDGE BLOCK / SECTION LOT 99 LOT AREA 2.186 SITE CLASS PS DESIGN FLOW 360GPD L.T.A.R. .256GPD/FT =

Septic Tank: 1000 Gallons: STB 1012 Date 12-7-01
Pump Tank: Gallons; PT Date
Pump Make: Model Serial No.
Nitrification Field: No Fields 1 Square Feet 960 Linear Feet 360
No Lines 3@120' Trench Width 36" Max Trench Bottom Depth 24" Gravel Depth N/A

☑ New System ☐ Repair System Type: I, II, (III), IV, V, VI
System Description: GRAVITY INNOVATIVE
Repair System Description: LPP
Maintenance Agreement Required: ☐ Yes ☑ No

☑ House/Mod. Home No. Bedrooms 3
☑ Mobile Home No. Bathrooms 3
☐ Business No. Employees
☐ Other


☐ Slab ☑ Crawl Space ☐ Basement w/plumbing ☐ Basement wo/plumbing

Water Supply: ☐ Individual ☑ Public ☐ Community

Comments:/Conditions:

Comments /Conditions: - Poly lok Filter Installed
- Septic Tank Marker Installed
- Installed 36-10FT Sections of EZ6 Leaf 130FT top dirt, 130FT middle stock, 100FT bottom dirt

INITIAL SITE SKETCH 1"=100'

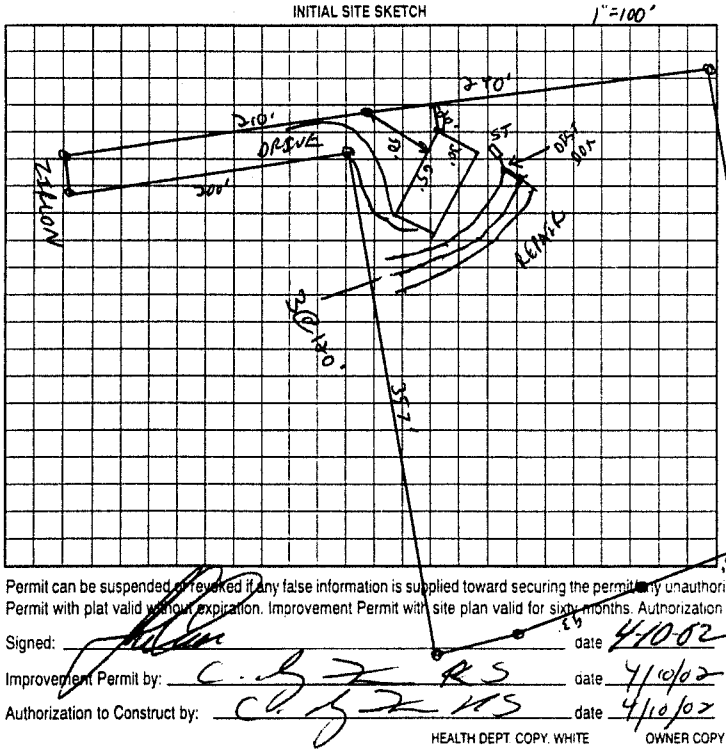

AS BUILT SKETCH

Installed as Shown Per Initial Site Sketch

Permit can be suspended or revoked if any false information is supplied toward securing the permit, any unauthorized changes are made to the site, any unauthorized changes are made in the installation of the system. Improvement Permit with plat valid without expiration. Improvement Permit with site plan valid for sixty months. Authorization to Construct is valid for a period equal to that of Improvement Permit – not to exceed sixty months.

Signed: date 4-10-02 Installed by: Tommy Cathern

Improvement Permit by: RS date 4/10/02 Operation Permit by: William O. Johnson date 5/29/02

Authorization to Construct by: RS date 4/10/02 Existing System Inspection by: date

HEALTH DEPT. COPY: WHITE OWNER COPY (FINAL): YELLOW OWNER COPY (INITIAL): PINK