IREDELL COUNTY HEALTH DEPARTMENT

STATESVILLE 704-878-5305 CI #130 MOORESVILLE 704-664-5281

IMPROVEMENT PERMIT / AUTHORIZATION TO CONSTRUCT / OPERATION PERMIT / EXISTING SYSTEM INSPECTION

PERMIT# 17339 ~~08442~~ PIN# 4705 86 1038 DATE 11/24/03

OWNER OR CONTRACTOR STONES EDGE - SHULTZ HOUSING PHONE: Business 663-2550 Home

ADDRESS 130 LAZY LANE MOORESVILLE NC 28117

LOCATION 64 (W) - TL LIPPARD FARM - TL STONES EDGE - TL GEMSTONE - ON RT

SUBDIVISION STONES EDGE BLOCK / SECTION LOT 21 LOT AREA .641AC SITE CLASS A5 DESIGN FLOW 450GPD L.T.A.R. .3600/Ac

Septic Tank: 1000 Gallons; STB 1012 Date 7-1-03

Pump Tank: Gallons; PT Date

Pump Make: Model Serial No.

Nitrification Field: No Fields 1 Square Feet 1200 Linear Feet 400

No Lines 5 C 80' Trench Width 36" Max Trench Bottom Depth 36" Gravel Depth N/A

☑ New System ☐ Repair System Type: I, II, III, IV, V, VI

System Description: GRADY 4 25% REDUCTION

Repair System Description: SAME

Maintenance Agreement Required: ☐ Yes ☑ No

☑ House/Mod. Home No. Bedrooms 4

☐ Mobile Home No. Bathrooms 4

☐ Business No. Employees

☐ Other


☐ Slab ☑ Crawl Space ☐ Basement w/plumbing ☐ Basement wo/plumbing

Water Supply: ☐ Individual ☑ Public ☑ Community


Comments:/Conditions:

Comments:/Conditions:

INITIAL SITE SKETCH

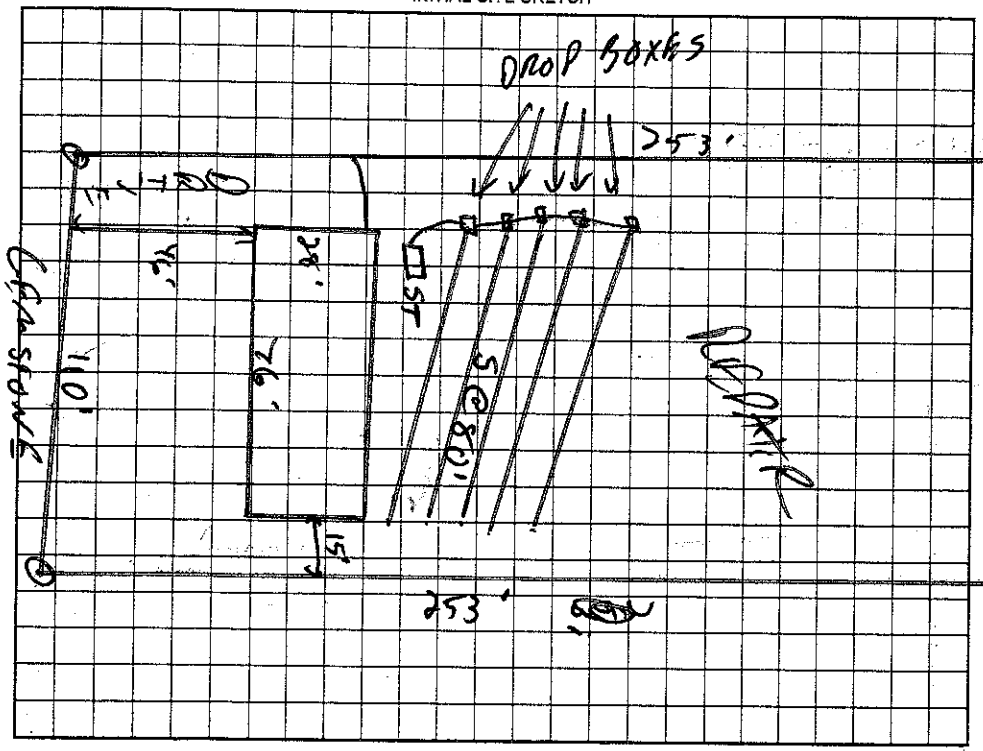

AS BUILT SKETCH

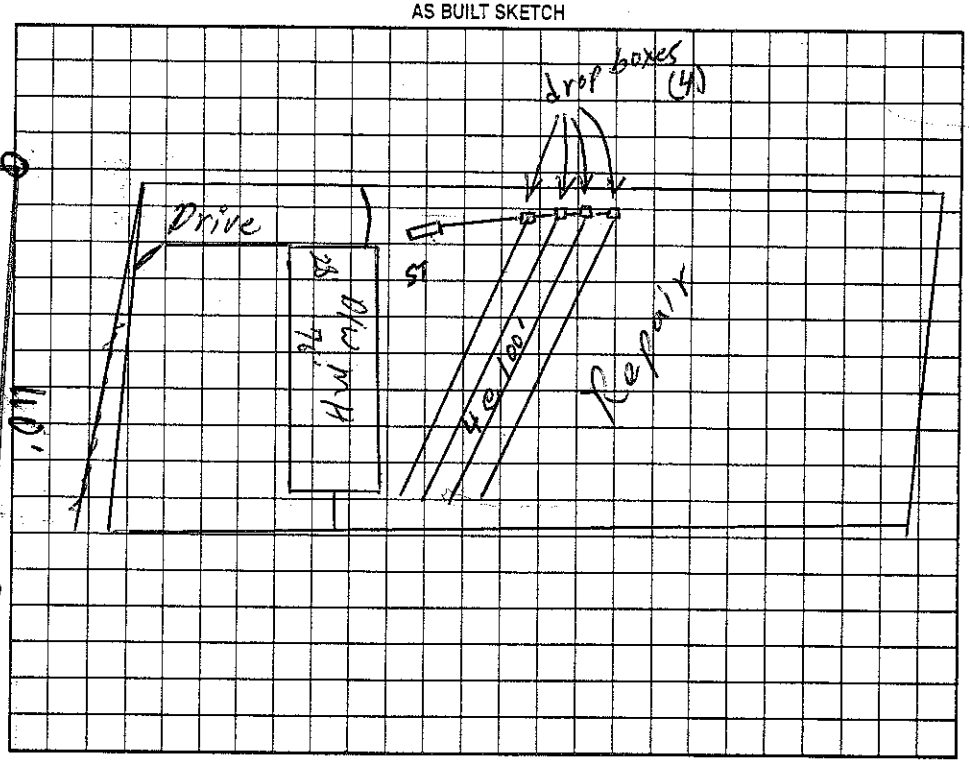

Permit can be suspended or revoked if any false information is supplied toward securing the permit/any unauthorized changes are made to the site/any unauthorized changes are made in the installation of the system. Improvement Permit with plat valid without expiration. Improvement Permit with site plan valid for sixty months. Authorization to Construct is valid for a period equal to that of Improvement Permit – not to exceed sixty months.

Signed: Sarah Grady date 11/25/03

Improvement Permit by: C. Hyatt RS date 11/24/03

Authorization to Construct by: C. Hyatt RS date 11/24/03

Installed by: A-1 Back hoe

Operation Permit by: William O. Johnson date 12/12/03

Existing System Inspection by: date

HEALTH DEPT. COPY: WHITE OWNER COPY (FINAL): YELLOW OWNER COPY (INITIAL): PINK