IREDELL COUNTY HEALTH DEPARTMENT

STATESVILLE 704-878-5305 CI $130 MOORESVILLE 704-664-5281

IMPROVEMENT PERMIT / AUTHORIZATION TO CONSTRUCT / OPERATION PERMIT / EXISTING SYSTEM INSPECTION

PERMIT# 108441 PIN# 4705862047 DATE 11/24/03

OWNER OR CONTRACTOR STONE LODGE INC / SHULTZ HOUSING PHONE: Business 663-2220 Home

ADDRESS 130 LAZY LANE MOORESVILLE

LOCATION 64 W - TL LEPPARD FARM - TL STONEGATE - TL ON STONE - ON RT

SUBDIVISION STONEGATE BLOCK / SECTION LOT 20 LOT AREA .641AC SITE CLASS. PS DESIGN FLOW 480GPD L.T.A.R. .3000/KI

Septic Tank: 1000 Gallons; STB 1012 Date 7-1-03

Pump Tank: Gallons; PT Date

Pump Make: Model Serial No.

Nitrification Field: No Fields 1 Square Feet 1200 Linear Feet 400

No Lines 5@80 Trench Width 36" Max Trench Bottom Depth 36" Gravel Depth N/A

☑ New System ☐ Repair System Type: I, II, III, IV, V, VI

System Description: GRAVITY 25% REDUCTION

Repair System Description: SAME

Maintenance Agreement Required: ☐ Yes ☑ No

☑ House/Mod. Home No. Bedrooms 4

☐ Mobile Home No. Bathrooms 4

☐ Business No. Employees

☐ Other

☐ Slab ☑ Crawl Space ☐ Basement w/plumbing ☐ Basement wo/plumbing


Water Supply: ☐ Individual ☑ Public ☐ Community

Comments:/Conditions:

Comments:/Conditions:

- 50 To Marker + Tuff Tite filter Installed
- Infiltrator Chamber Installed.
House Not set on lot yet.

INITIAL SITE SKETCH 1"=50'

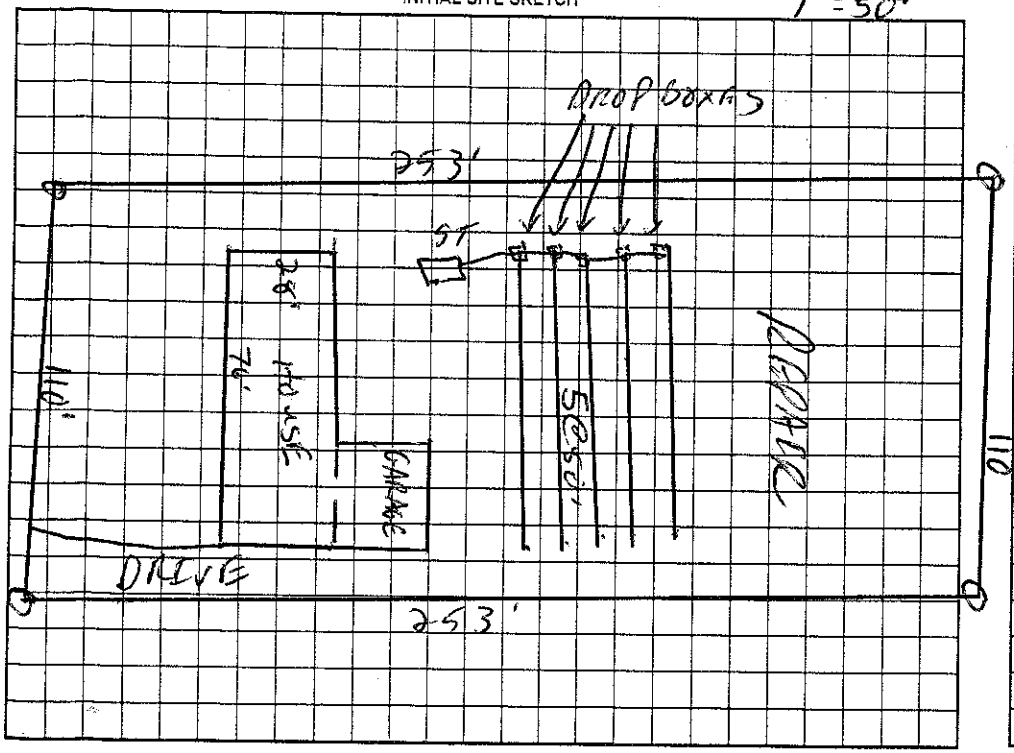

AS BUILT SKETCH

Installed as Shown

per Initial Site Sketch

Permit can be suspended or revoked if any false information is supplied toward securing the permit/any unauthorized changes are made to the site/any unauthorized changes are made in the installation of the system. Improvement Permit with plat valid without expiration. Improvement Permit with site plan valid for sixty months. Authorization to Construct is valid for a period equal to that of Improvement Permit – not to exceed sixty months.

Signed: Sarah Grundy date 11/25/03

Improvement Permit by: C. Lyle MS date 11/24/03

Authorization to Construct by: C. Lyle MS date 11/24/03

Installed by: A-1 Backhoe

Operation Permit by: [redacted] William Johnson date 12/22/03

Existing System Inspection by: date

HEALTH DEPT. COPY: WHITE OWNER COPY (FINAL): YELLOW OWNER COPY (INITIAL): PINK