IREDELL COUNTY HEALTH DEPARTMENT

STATESVILLE 704-878-5305 $55.00 Paid MOORESVILLE 704-664-5281

IMPROVEMENT PERMIT / AUTHORIZATION TO CONSTRUCT / OPERATION PERMIT / EXISTING SYSTEM INSPECTIO.

PERMIT# 102615 PIN# 4705858934.12 DATE 8/23/02

OWNER OR CONTRACTOR STONES EDGE INC. PHONE Business 663-3220 Home

ADDRESS 130 LAZY LANE . MOORESVILLE NC 28117

LOCATION 64 W- TL LIPPARD FARM RD - TL STONES EDGE IL GEMSTONE ON LT

SUBDIVISION STONES EDGE BLOCK / SECTION LOT 12 LOT AREA .45AC SITE CLASS PS DESIGN FLOW 360GPD L.T.A.R. .36 ROCKS

Septic Tank: 1000 Gallons: STB 794 Date 06/08/02
Pump Tank: Gallons; PT Date
Pump Make: Model Serial No.
Nitrification Field: No Fields 1 Square Feet 900 Linear Feet 300
No Lines 4@15' Trench Width 36" Max Trench Bottom Depth 36" Gravel Depth N/A

☒ New System ☐ Repair System Type: I II III IV V VI
System Description: GRAVITY 25% REDUCTION
Repair System Description: SAME
Maintenance Agreement Required: ☐ Yes ☒ No
☐ Slab ☒ Crawl Space ☐ Basement w/plumbing ☐ Basement wo/plumbing


☒ House/Mod. Home No. Bedrooms 3
☐ Mobile Home No. Bathrooms 3
☐ Business No. Employees
☐ Other

Water Supply: ☐ Individual ☒ Public ☒ Community

Comments:/Conditions:

Comments:/Conditions:
- SEPTIC TANK INSTALLED USING ZEBEL FILTER + SEPTIC MARKER

INITIAL SITE SKETCH 1"=50'

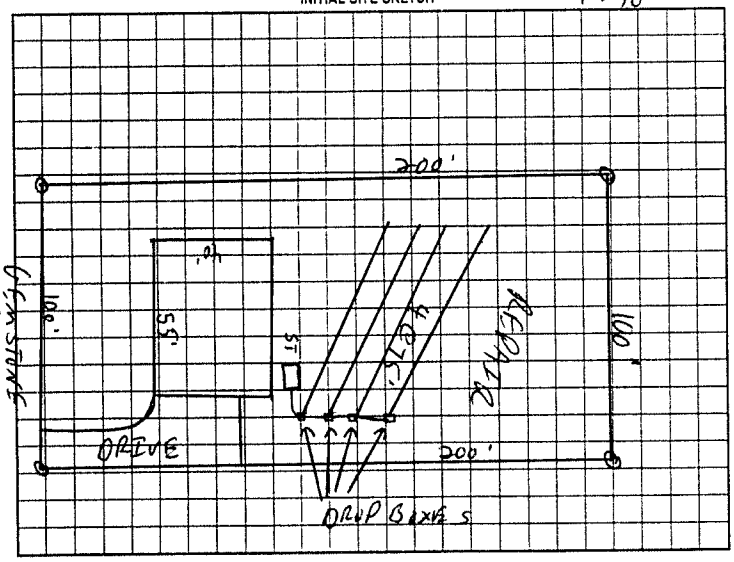

AS BUILT SKETCH

- SYSTEM INSTALLED AS SHOWN ON INTIAL SITE SKETCH

Permit can be suspended or revoked if any false information is supplied toward securing the permit/any unauthorized changes are made to the site any unauthorized changes are made in the installation of the system. Improvement Permit with plat valid without expiration. Improvement Permit with site plan valid for sixty months. Authorization to Construct is valid for a period equal to that of Improvement Permit – not to exceed sixty months.

Signed: date 8-23-02 Installed by: BOBS BACKHOE

Improvement Permit by: C. Yates RS date 8/23/02 Operation Permit by: Patrick Mitchell date 10/03/02

Authorization to Construct by: C. Yates RS date 8/23/02 Existing System Inspection by: date

HEALTH DEPT COPY. WHITE OWNER COPY (FINAL) YELLOW OWNER COPY (INITIAL) PINK