DELL COUNTY HEALTH DEPARTMENT

THIS PERMIT VOIDS PREVIOUS ISSUED 10-21-04

STATESVILLE 704-878-5305 MOORESVILLE 704-664-5281

IMPROVEMENT PERMIT / AUTHORIZATION TO CONSTRUCT / OPERATION PERMIT / EXISTING SYSTEM INSPECTION

PERMIT# 10997316066 PIN# 4705-86-3334 DATE 3-16-05

OWNER OR CONTRACTOR STONES EDGE, INC PHONE: Business 704-534-4700 Home 704-609-7745

ADDRESS 130 LAZY LANE, MOORESVILLE, NC 28117

LOCATION LIPPARD FARM RD, TO STONES EDGE DR, TL GEMSTONE DRIVE, NEAR END ON LEFT

SUBDIVISION STONES EDGE BLOCK / SECTION ____ LOT 13 LOT AREA 110' x 200 SITE CLASS. PS DESIGN FLOW 360 L.T.A.R. 0.25 GPD/FT²

Septic Tank: 1000 Gallons; STB 760 Date 10-13-09

Pump Tank: ____ Gallons; PT ____ Date ____

Pump Make: ____ Model ____ Serial No. ____

Nitrification Field: No Fields 1 Square Feet EQ TO 1440 Linear Feet 360

No Lines FOUR Trench Width 36" Max Trench Bottom Depth 36" Gravel Depth N/A

☑ New System ☐ Repair System Type: I, II, (III), IV, V, VI

System Description: 25% REDUCTION, GRAVITY

Repair System Description: 50% REDUCTION, LOW PRESSURE

Maintenance Agreement Required: ☐ Yes ☑ No ☐ Other

☑ House/Mod. Home ☐ Mobile Home ☐ Business No. Bedrooms 3 No. Bathrooms ____ No. Employees ____


☐ Slab ☑ Crawl Space ☐ Basement w/plumbing ☐ Basement wo/plumbing

Water Supply: ☐ Individual ☑ Public ☐ Community


Comments:/Conditions: INSTALL 25% REDUCTION SYSTEM ON CONTOUR AS SHOWN

Comments:/Conditions:

INITIAL SITE SKETCH

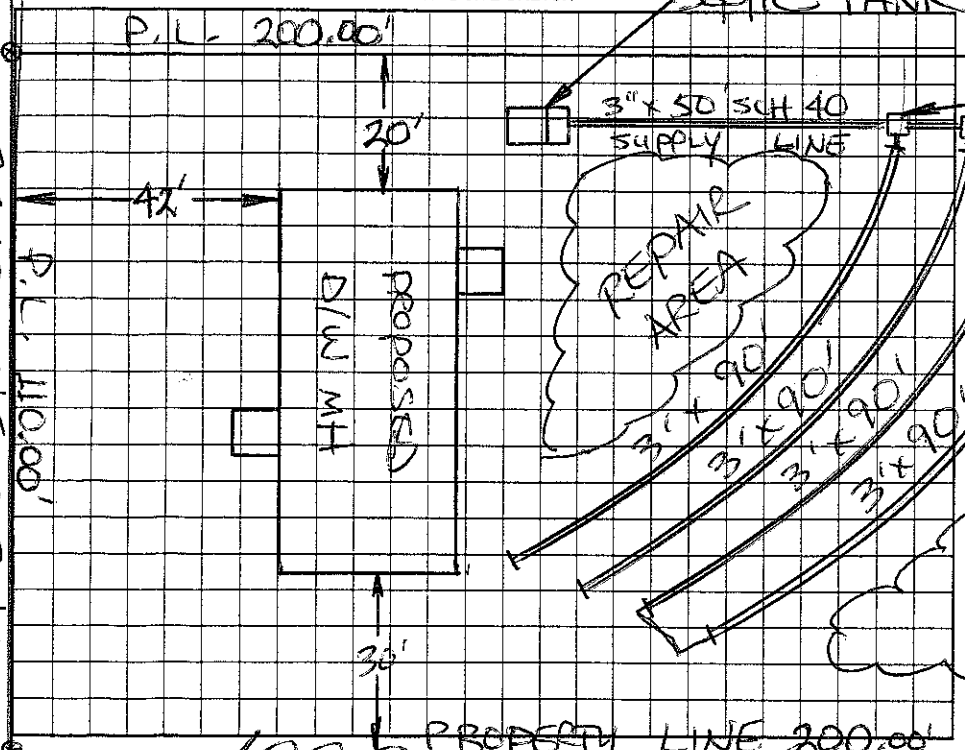

AS BUILT SKETCH

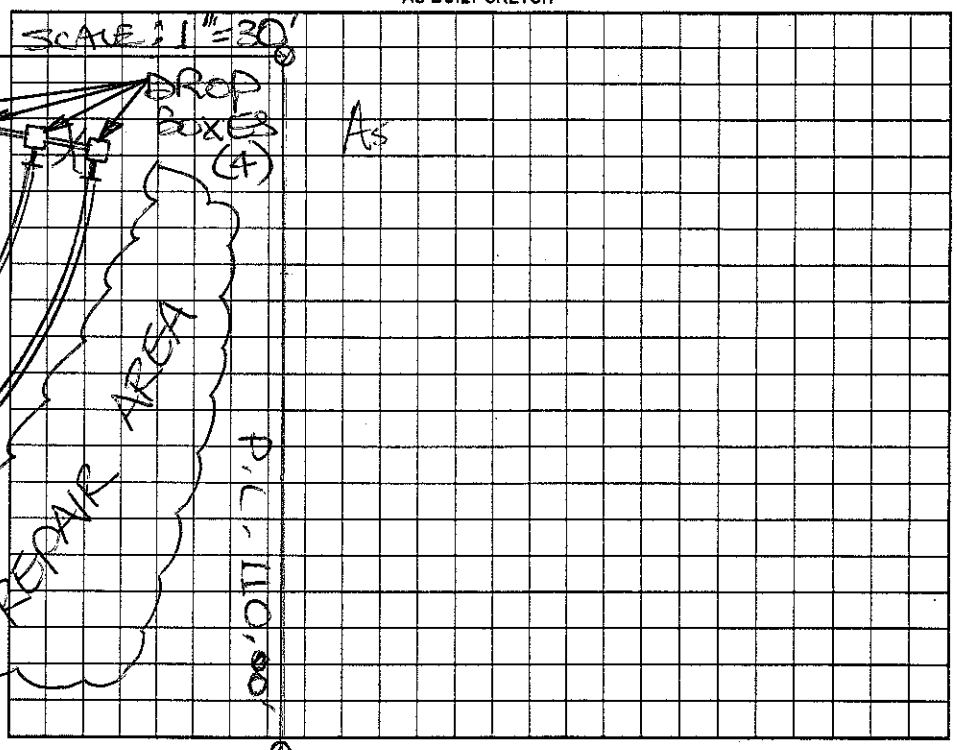

Permit can be suspended or revoked if any false information is supplied toward securing the permit/any unauthorized changes are made to the site/any unauthorized changes are made in the installation of the system. Improvement Permit with plat valid without expiration. Improvement Permit with site plan valid for sixty months. Authorization to Construct is valid for a period equal to that of Improvement Permit – not to exceed sixty months.

Signed: [signature] / Erin Ward 4/1/10 date 8-23-05 Installed by: A-1 Backhoe

Improvement Permit by: STEVE HEDRICK date 3-16-05 Operation Permit by: [signature] date 5-6-10

Authorization to Construct by: STEVE HEDRICK date 3-16-05 Existing System Inspection by: ____ date ____

HEALTH DEPT. COPY: WHITE OWNER COPY (FINAL): YELLOW OWNER COPY (INITIAL): PINK

Nick Hartsell 101 GEMSTONE DRIVE

New owner - Nick Hartsell