IREDELL COUNTY HEALTH DEPARTMENT

STATESVILLE 704-878-5305 — MOORESVILLE 704-664-5281

IMPROVEMENT PERMIT / AUTHORIZATION TO CONSTRUCT / OPERATION PERMIT / EXISTING SYSTEM INSPECTIO

PERMIT# 1047720 PIN# 4705 86 6024 DATE 2/22/02

OWNER OR CONTRACTOR STONES EDGE INC. PHONE: Business 663-2220 Home

ADDRESS 130 LAZY LANE MOORESVILLE NC 28117

LOCATION 64W - TL LIPPARD FARM - TL STONES EDGE - TL GEMSTONE - 1ST LAST ON RT

SUBDIVISION STONES EDGE BLOCK / SECTION LOT 17 LOT AREA 1.09AC SITE CLASS PS DESIGN FLOW 360GPD L.T.A.R. 36.0/F1

Septic Tank: 1000 Gallons; STB 1012 Date 9-22-01
Pump Tank: Gallons; PT Date
Pump Make: Model Serial No
Nitrification Field: No Fields 1 Square Feet 1000 Linear Feet 400
No Lines 5 Trench Width 36" Max Trench Bottom Depth 36"

☑ New System ☐ Repair System Type: I (II) III IV V VI
System Description: GRAVITY CONVENTIONAL
Repair System Description: SAME
Maintenance Agreement Required: ☐ Yes ☑ No
Gravel Depth 12" ☐ Slab ☐ Crawl Space ☐ Basement w/plumbing ☐ Basement wo/plumbing


☑ House/Mod. Home No. Bedrooms 3
☐ Mobile Home No. Bathrooms 3
☐ Business No. Employees
☐ Other

Water Supply: ☐ Individual ☑ Public ☐ Community


Comments/Conditions:

Comments/Conditions: - Polylok Filter Installed - Spin Tank ~~Marker~~ Installed Marker

INITIAL SITE SKETCH

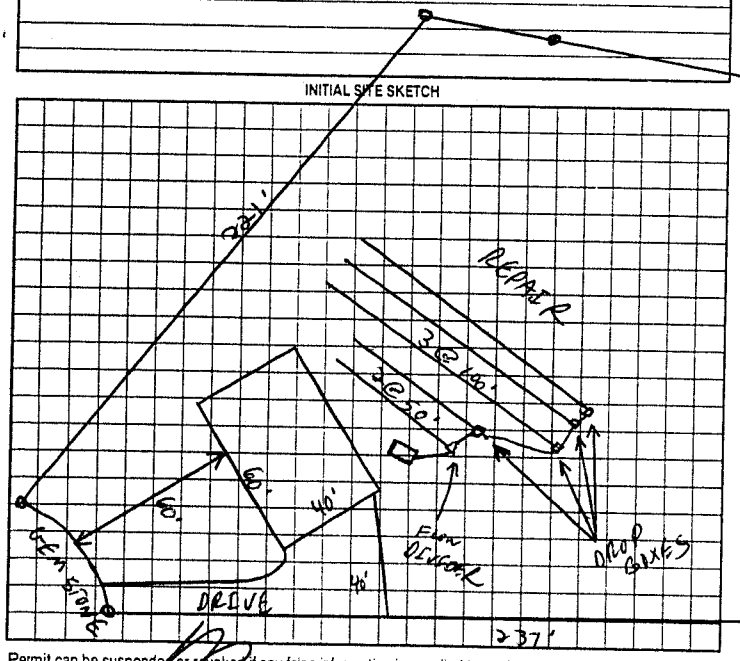

AS BUILT SKETCH Not to Scale

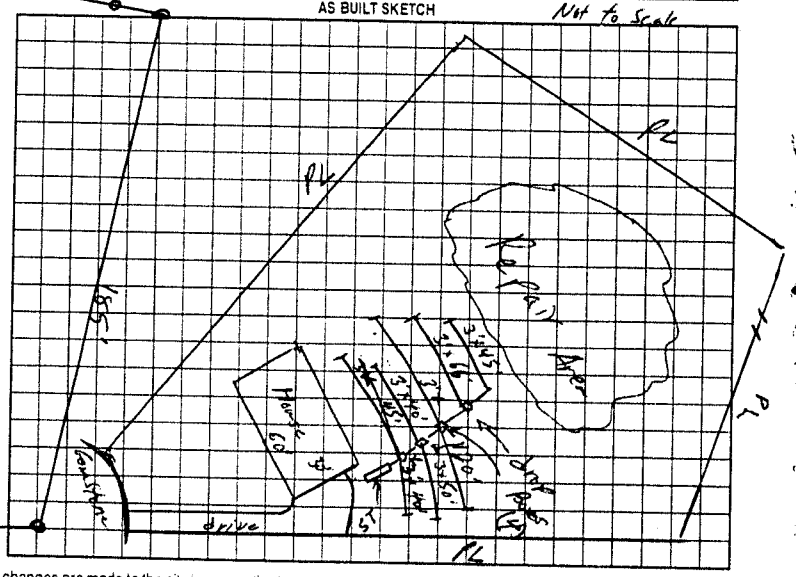

Permit can be suspended or revoked if any false information is supplied toward securing the permit/any unauthorized changes are made to the site any unauthorized changes are made in the installation of the system. Improvement Permit with plat valid without expiration. Improvement Permit with site plan valid for sixty months. Authorization to Construct is valid for a period equal to that of Improvement Permit – not to exceed sixty months

Signed: _____ date 2-22-02 Installed by: A-1 Backhoe

Improvement Permit by: C. Hicks date 2/22/02 Operation Permit by: William O. Johnson date 3/5/02

Authorization to Construct by: C. Hicks date 2/22/02 Existing System Inspection by: _____ date _____

HEALTH DEPT COPY. WHITE OWNER COPY (FINAL) YELLOW OWNER COPY (INITIAL) PINK