IREDELL COUNTY HEALTH DEPARTMENT

STATESVILLE 704-878-5305 MOORESVILLE 704-664-5281

IMPROVEMENT PERMIT / AUTHORIZATION TO CONSTRUCT / OPERATION PERMIT / EXISTING SYSTEM INSPECTION

$130 C1

PERMIT# 119223 PIN# 4705 86 ~~96 17~~ 9535 DATE 2/20/04

OWNER OR CONTRACTOR STONESEDGE / FLEETWOOD PHONE: Business 663-2220 Home

ADDRESS 130 LAZY LN MOORESVILLE NC 28117

LOCATION 64W- TL LIPPARD FARM - TL STONESEDGE, TR ZIRCON - TL PERIDOT - ON LT

SUBDIVISION STONESEDGE BLOCK / SECTION LOT 112 LOT AREA 2.61AC SITE CLASS. PS DESIGN FLOW ~~360~~ 480 L.T.A.R. .36 PT 2

Septic Tank: 1000 Gallons; STB 1012 Date 3-1-04

Pump Tank: 1000 Gallons; PT 17 Date 6-15-03

Pump Make: Myers Model ME50 Serial No. —

Nitrification Field: No Fields 1 Square Feet 1200 Linear Feet 400

No Lines 5 Trench Width 36" Max Trench Bottom Depth 36" Gravel Depth N/A

☑ New System ☐ Repair System Type: I, II, (III), IV, V, VI

System Description: PUMP 25% REDUCTION

Repair System Description: LP PANEL

Maintenance Agreement Required: ☐ Yes ☑ No

☑ House/Mod. Home No. Bedrooms 4

☐ Mobile Home No. Bathrooms 4

☐ Business No. Employees

☐ Other


☐ Slab ☑ Crawl Space ☐ Basement w/plumbing ☐ Basement wo/plumbing

Water Supply: ☐ Individual ☑ Public ☐ Community


Comments:/Conditions: 3@80' and 2@40'
*DO NOT CUT HOUSE @ PAD. XX

Comments:/Conditions: Lines (5) Five installed, okay; Tuff Tite Effort ST Marker + ST Riser on Pump Tank Installed - 7/26 cyl. + Float tree + Pressure Check okay 8/26/04.

INITIAL SITE SKETCH 1"=10'

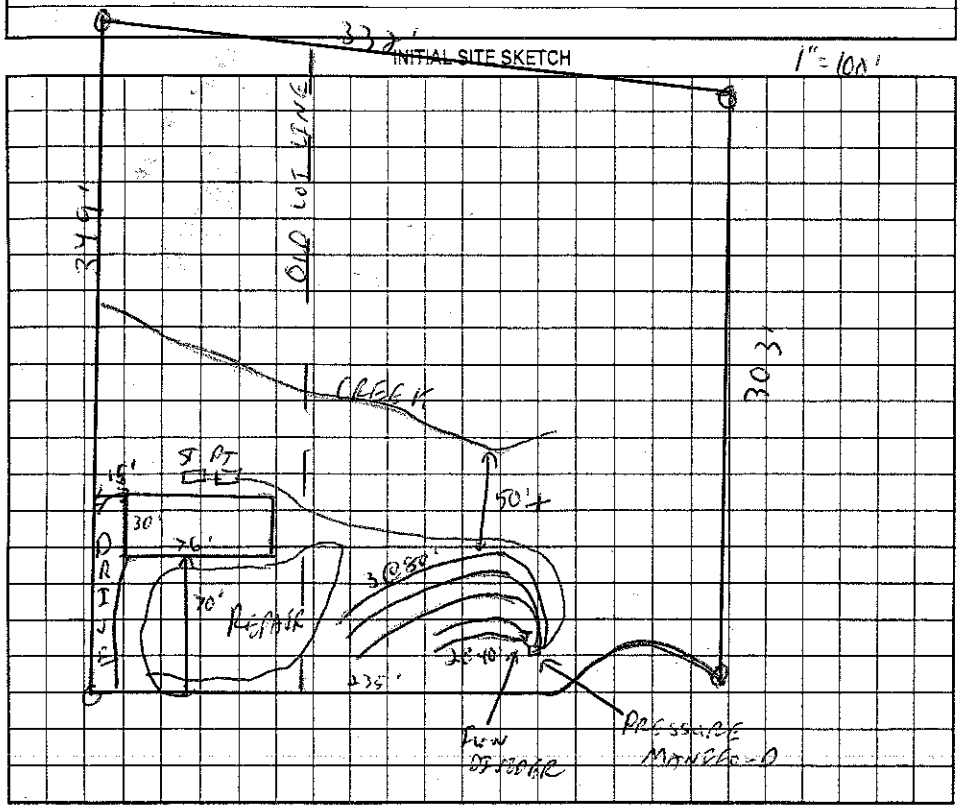

AS BUILT SKETCH

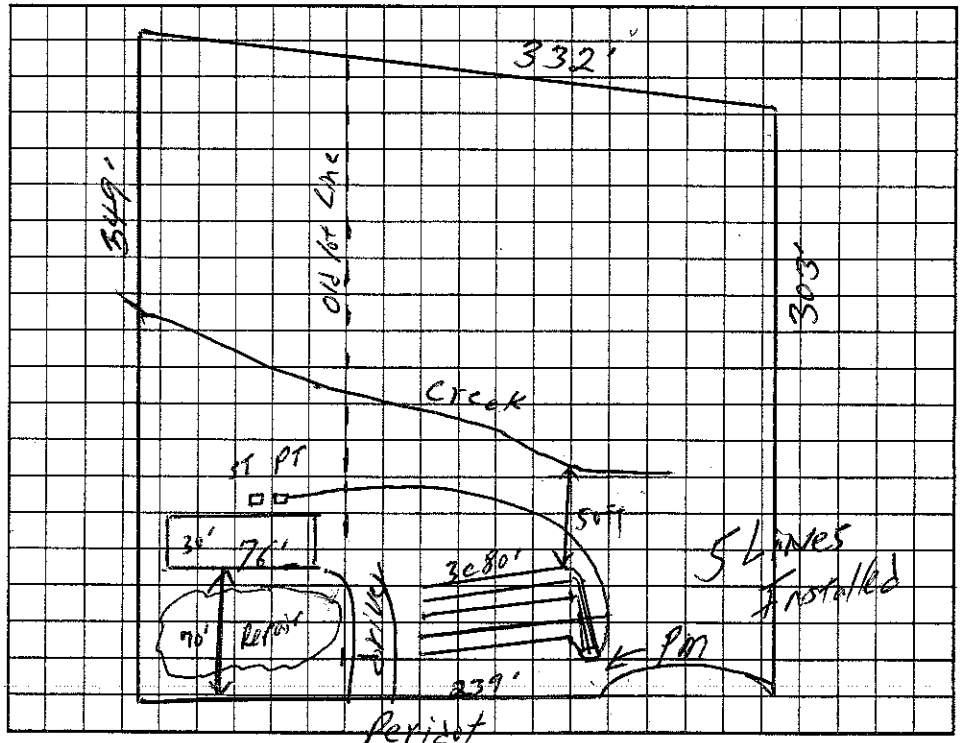

Permit can be suspended or revoked if any false information is supplied toward securing the permit/any unauthorized changes are made to the site/any unauthorized changes are made in the installation of the system. Improvement Permit with plat valid without expiration. Improvement ~~Permit with~~ site plan valid for sixty months. Authorization to Construct is valid for a period equal to that of Improvement Permit – not to exceed sixty months.

Signed: CR date

Installed by: Craig Thompson 8/26/04

Improvement Permit by: C. Yoder HS date 2/20/04

Operation Permit by: STEVE HENDRICK date 9-14-04

Authorization to Construct by: C. Yoder HS date 2/20/04

Existing System Inspection by: date

HEALTH DEPT. COPY: WHITE OWNER COPY (FINAL): YELLOW OWNER COPY (INITIAL): PINK