IREDELL COUNTY HEALTH DEPARTMENT

STATESVILLE 704-878-5305 130.00 Paid MOORESVILLE 704-664-5281

IMPROVEMENT PERMIT / AUTHORIZATION TO CONSTRUCT / OPERATION PERMIT / EXISTING SYSTEM INSPECTION

PERMIT# 106011 PIN# 4705 86 6304 DATE 4/11/02

OWNER OR CONTRACTOR STONES EDGE PHONE: Business 663-2220 Home

ADDRESS 130 LAZY LANE MOORESVILLE

LOCATION 64 W - TL LEPPARD FARM - TL STONES EDGE - TL GEMSTONE - TR ZIRCON - TL PERIDOT ON IN CUL DE SAC

SUBDIVISION STONES EDGE BLOCK / SECTION LOT 41 LOT AREA SITE CLASS PS DESIGN FLOW 360 GPD L.T.A.R. 360 GPD/SQ FT

Septic Tank: 1000 Gallons: STB 1012 Date 12-20-01
Pump Tank: 1000 Gallons: PT 17 Date 2-18-02
Pump Make: Hydromatic Model SHE50A-1 Serial No. —
Nitrification Field: No Fields 1 Square Feet 900 Linear Feet 300
No Lines 3 @ 100' Trench Width 36" Max Trench Bottom Depth 36" Gravel Depth N/A

☑ New System ☐ Repair System Type: I, II, (III), IV, V, VI
System Description: PUMP INNOVATIVE
Repair System Description: SAME
Maintenance Agreement Required: ☐ Yes ☑ No


☑ House/Mod. Home No. Bedrooms 3
☐ Mobile Home No. Bathrooms 3
☐ Business No. Employees
☐ Other
☐ Slab ☐ Crawl Space ☐ Basement w/plumbing ☐ Basement wo/plumbing

Water Supply: ☐ Individual ☑ Public ☐ Community

Comments:/Conditions:

Comments:/Conditions: Installed 3 @ 100' - three liners - okay; Poly Lok Filter Installed; S Thackery, PT Owner Installer,

INITIAL SITE SKETCH 1" = 100'

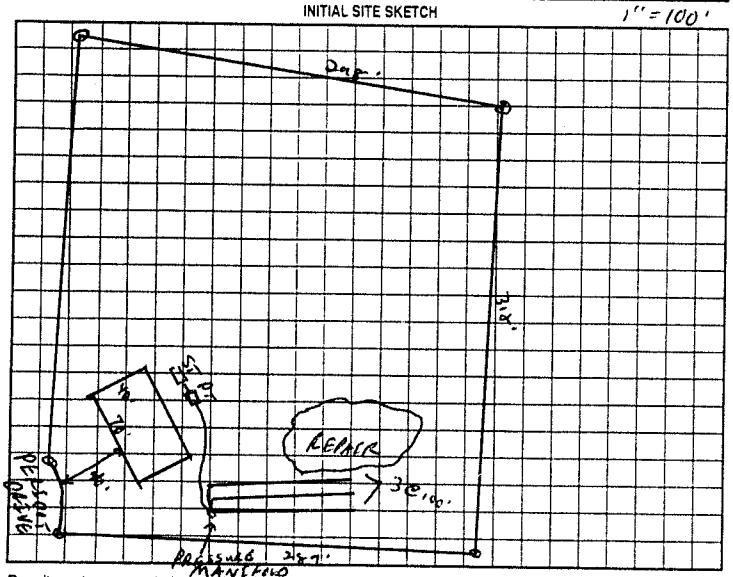

AS BUILT SKETCH

SET PRESSURE (22)
NEEDS ELECTRICAC
Electrical + Alarm OKAY
4/30/02 w-ol

Installed as Shown Per Final Site Sketch

Permit can be suspended or revoked if any false information is supplied toward securing the permit/any unauthorized changes are made to the site any unauthorized changes are made in the installation of the system. Improvement Permit with plat valid without expiration. Improvement Permit with site plan valid for sixty months. Authorization to Construct is valid for a period equal to that of Improvement Permit - not to exceed sixty months.

Signed: [signature] date 4-11-02 Installed by: A-1 Backhoe

Improvement Permit by: C. Lyon RS date 4/11/02 Operation Permit by: William G Johnson date 4/30/02

Authorization to Construct by: C. Lyon RS date 4/11/02 Existing System Inspection by: date

HEALTH DEPT COPY WHITE OWNER COPY (FINAL) YELLOW OWNER COPY (INITIAL) PINK