IREDELL COUNTY HEALTH DEPARTMENT

Statesville Phone TR 3-7271 Mooresville Phone NO 3-1271

PERMIT TO INSTALL SEPTIC TANK

Permit NO. _____ Permit Date Nov 18 1958

Owner Dave Pritchard #1 Address Talys Rd. before Scotts

Installed By C Hoke Address Rt 7.


Location of Property On left 2 houses above Don Mayfield Store Sta. new brick

Tank		Capacity		Length of Lines		Fixtures	
Block	( )	800	(1)	150'	(1)	No. of Baths	(1)
Precast	(1)	900	( )	175'	( )	Dishwasher	( )
		1000	( )	200'	( )	Garbage Grdr.	( )
		1100	( )	225'	( )	Auto-Washer	( )
		1200	( )	250'	( )	Other	
		Other		Other			

NOTIFY HEALTH DEPARTMENT AT LEAST EIGHT HOURS BEFORE TANK IS TO BE INSPECTED.

Final Inspection Nov 18 1958 Approved ( ) Disapproved ( )

Remarks House gets water from central well.

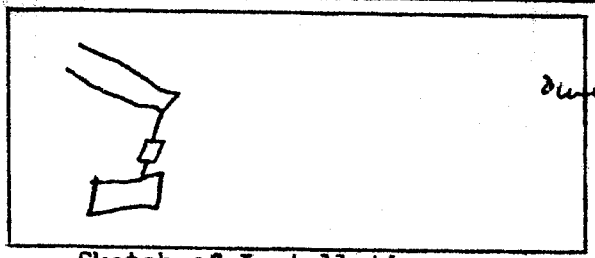

Sketch of Installation

R.G.I

Sanitarian