IREDELL COUNTY HEALTH DEPARTMENT

CJ 50.00 Paid

STATESVILLE 704-878-5305 MOORESVILLE 704-664-5281

IMPROVEMENT PERMIT / AUTHORIZATION TO CONSTRUCT / OPERATION PERMIT / EXISTING SYSTEM INSPECTION

PERMIT# 102622 PIN# ~~4705554934.54~~ 4705-95-1688 DATE 7/17/03

OWNER OR CONTRACTOR ~~Owner~~ STONES EDGE INC. PHONE: Business 663-2220 Home

ADDRESS 130 LAZY LANE MOORESVILLE NC 28115

LOCATION 64W - TL LIPPARD FARM - TL STONES EDGE - TL HEMSTONE - TR ZIRCON - TL PERIDOT - ON RT CORNER

SUBDIVISION STONES EDGE BLOCK / SECTION LOT 51 LOT AREA 1.54 AC SITE CLASS. PS DESIGN FLOW 400 GPD L.T.A.R. .36 PD/FT²

Septic Tank: 1000 Gallons; STB 1012 Date 1-26-03

Pump Tank: Gallons; PT Date

Pump Make: Model Serial No.

Nitrification Field: No Fields 1 Square Feet 1200 ~~1600~~ Linear Feet 400

No Lines 5 Trench Width 36" Max Trench Bottom Depth 36" Gravel Depth N/A

☑ New System ☐ Repair System Type: I, II, III, IV, V, VI

System Description: GRAVITY 25% REDUCTION

Repair System Description: LP PANEL

Maintenance Agreement Required: ☐ Yes ☑ No

☑ House/Mod. Home No. Bedrooms 4

☐ Mobile Home No. Bathrooms 4

☐ Business No. Employees

☐ Other

☐ Slab ☑ Crawl Space ☐ Basement w/plumbing ☐ Basement wo/plumbing


Water Supply: ☐ Individual ☑ Public ☐ Community

Comments:/Conditions:


Comments:/Conditions:

ST marker + Turf Tite Filter Installed
400 SF of EZ Lay installed
- House not located on lot @ time of inspection

INITIAL SITE SKETCH 1" = 50'

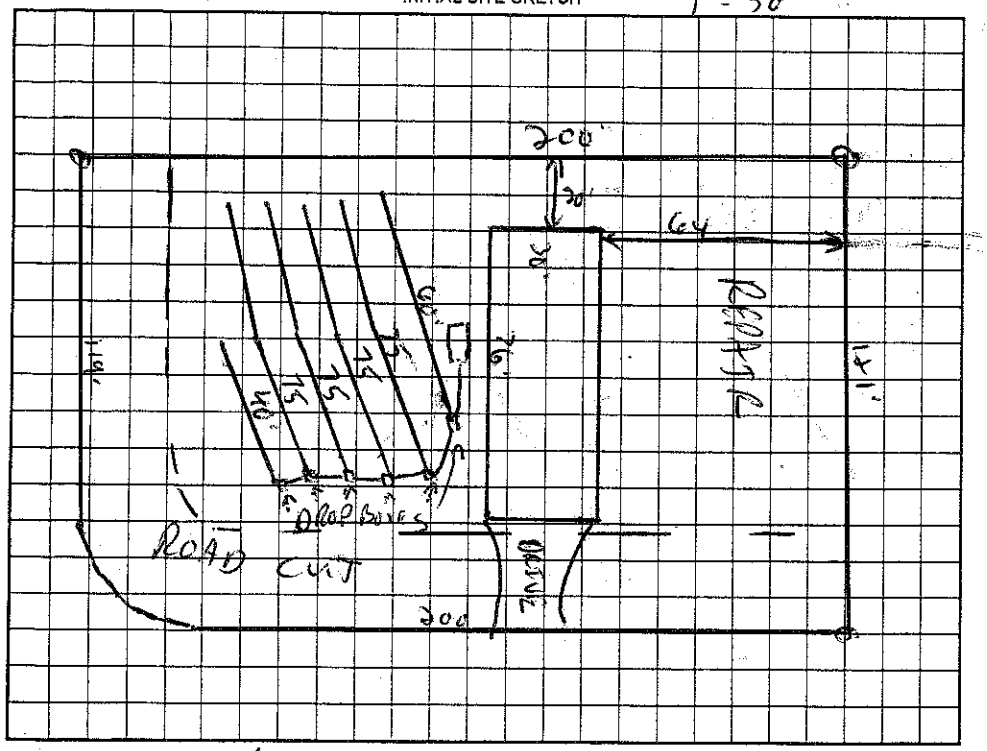

AS BUILT SKETCH

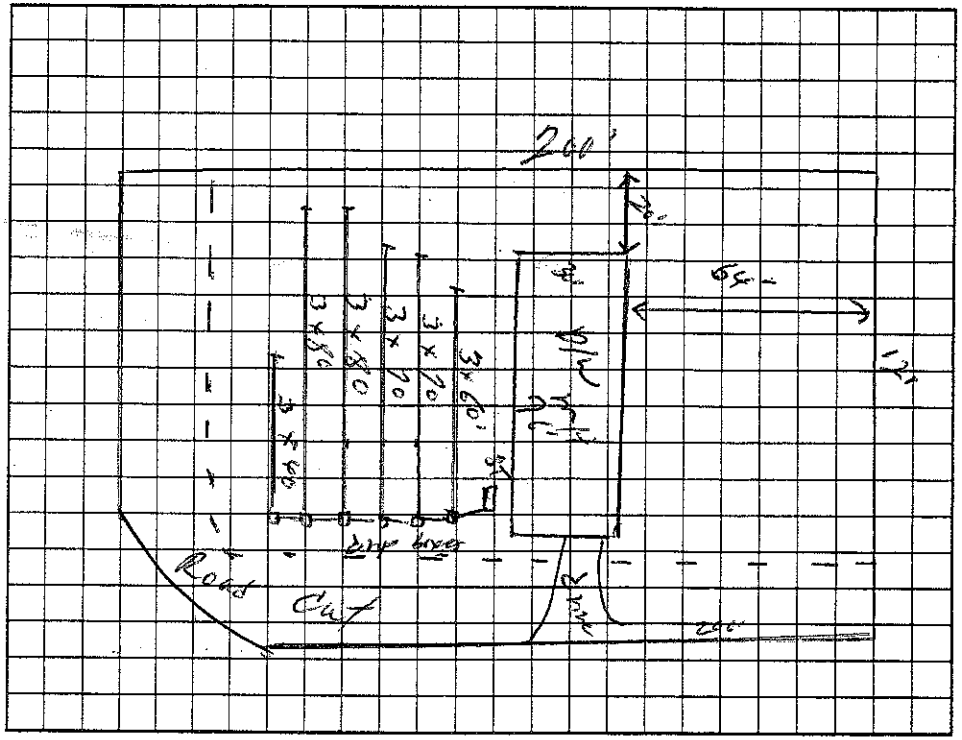

Permit can be suspended or revoked if any false information is supplied toward securing the permit/any unauthorized changes are made to the site/any unauthorized changes are made in the installation of the system. Improvement Permit with plat valid without expiration. Improvement Permit with site plan valid for sixty months. Authorization to Construct is valid for a period equal to that of Improvement Permit – not to exceed sixty months.

Signed: date 7-18-03

Improvement Permit by: C. Sy RS date 7/17/03

Authorization to Construct by: C. Sy RS date 7/17/03

Installed by: Craig Thompson

Operation Permit by: William O. Johnson date 8-15-03

Existing System Inspection by: date

HEALTH DEPT. COPY: WHITE OWNER COPY (FINAL): YELLOW OWNER COPY (INITIAL): PINK