IREDELL COUNTY HEALTH DEPARTMENT

STATESVILLE 704-878-5305 — MOORESVILLE 704-664-5281

IMPROVEMENT PERMIT / AUTHORIZATION TO CONSTRUCT / OPERATION PERMIT / EXISTING SYSTEM INSPECTION

PERMIT# 10262 1 PIN# 4705858934.50 DATE 10/15/01

OWNER OR CONTRACTOR JOHN CRAVER PHONE: Business 663-2220 Home

ADDRESS 130 LAZY LN MOOVESVILLE NC 28117

LOCATION HWY 64 WEST - TL LIPPARD FARM - TL STONES EDGE - TL GEMSTONE - TR ZIRCON - TL PERIDOT - 2ND ON RT

SUBDIVISION STONES EDGE BLOCK / SECTION LOT 50 LOT AREA .505 SITE CLASS PS DESIGN FLOW 360 GPD L.T.A.R. .50 PER FT2

Septic Tank: 1000 Gallons: STB 1012 Date 9-10-01

Pump Tank: Gallons: PT Date

Pump Make: Model Serial No.

Nitrification Field: No Fields 1 Square Feet 1200 Linear Feet 400

No Lines 5 @ 80' Trench Width 36" Max Trench Bottom Depth 36" Gravel Depth 12"

~~New System~~ ☐ Repair System Type: I (II) III IV V VI

System Description: GRAVITY CONVENTIONAL

Repair System Description: CP PANEL

Maintenance Agreement Required: ☐ Yes ☑ No

~~House/Mod. Home~~ ☐ Mobile Home ☐ Business ☐ Other

No. Bedrooms 3 No. Bathrooms 3 No. Employees


☐ Slab ☐ Crawl Space ☐ Basement w/plumbing ☐ Basement wo/plumbing

Water Supply: ☑ Individual ~~Public~~ ☐ Community


Comments/Conditions: 1) FILL UP AGAINST HOUSE TO ACHIEVE POSITIVE DRAINAGE - DO NOT CUT LOT.

Comments/Conditions:
- Septic Tank Marker Installed
- Poly Lok Filter Installed

INITIAL SITE SKETCH 1"=50'

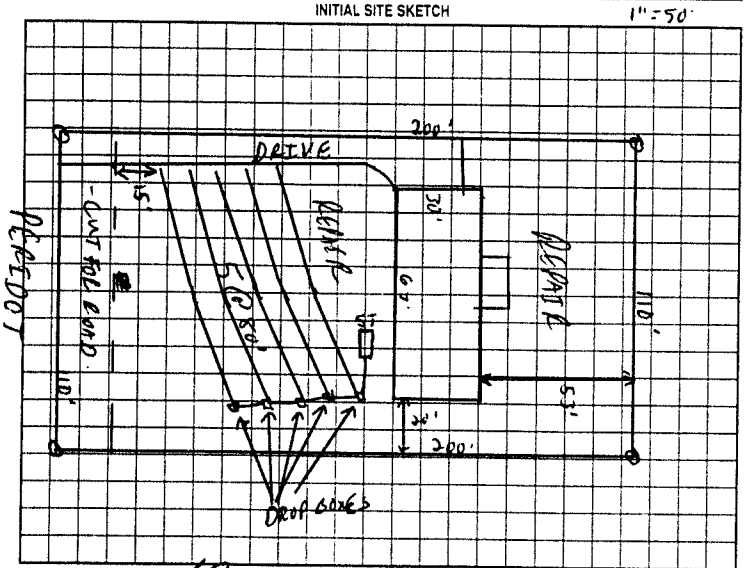

AS BUILT SKETCH

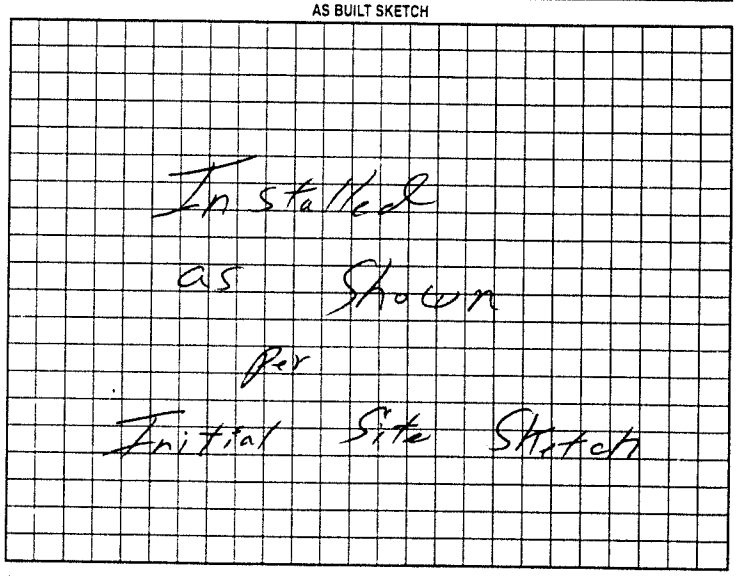

Permit can be suspended or revoked if any false information is supplied toward securing the permit/any unauthorized changes are made to the site/any unauthorized changes are made in the installation of the system. Improvement Permit with plat valid without expiration. Improvement Permit with site plan valid for sixty months. Authorization to Construct is valid for a period equal to that of Improvement Permit – not to exceed sixty months.

Signed: [signature] 11-2-01 date 11-02-01 Installed by: A-1 Backhoe

Improvement Permit by: C. [signature] LS date 10/15/01 Operation Permit by: William O. Johnson date 11/7/01

Authorization to Construct by: William O. Johnson date 11/7/01 Existing System Inspection by: date

HEALTH DEPT. COPY WHITE OWNER COPY (FINAL) YELLOW OWNER COPY (INITIAL) PINK