IREDELL COUNTY HEALTH DEPARTMENT

STATESVILLE 704-878-5305 25.00 Paid MOORESVILLE 704-664-5281

IMPROVEMENT PERMIT / AUTHORIZATION TO CONSTRUCT / OPERATION PERMIT / EXISTING SYSTEM INSPECTION

PERMIT# 104496 PIN# 4705 95 2225 DATE 2/5/02

OWNER OR CONTRACTOR STONES EDGE PHONE: Business 663 2220 Home

ADDRESS 130 LAZY LANE MOORESVILLE NC 28117

LOCATION 64W - TL LIPPARD FARM - TL STONES EDGE - TL GEMSBNE - TR TITANIUM - AT END

SUBDIVISION STONES EDGE BLOCK / SECTION LOT 94 LOT AREA 1.863 SITE CLASS RS DESIGN FLOW 480 GPD L.T.A.R. .36PD/LTA

Septic Tank: 1000 Gallons: STB 294 Date 11-5-01

Pump Tank: Gallons: PT Date

Pump Make: Model Serial No.

Nitrification Field: No Fields 1 Square Feet 1596 Linear Feet 532

No Lines 4@133' Trench Width 36" Max Trench Bottom Depth 36" Gravel Depth 12"

☑ New System ☐ Repair System Type: I (II) III IV V VI

System Description: GRAVITY CONVENTIONAL

Repair System Description: GRAVITY 25% REDUCTION

Maintenance Agreement Required: ☐ Yes ☑ No

☐ Slab ☑ Crawl Space ☐ Basement w/plumbing ☐ Basement wo/plumbing

☑ House/Mod Home No. Bedrooms 4

☑ Mobile Home No. Bathrooms 4

☐ Business No. Employees

☐ Other


Water Supply: ☐ Individual ☑ Public ☐ Community

Comments/Conditions:


Comments/Conditions

- Label Filter Installed
- Septic Tank Marker Installed

INITIAL SITE SKETCH 1" = 100'

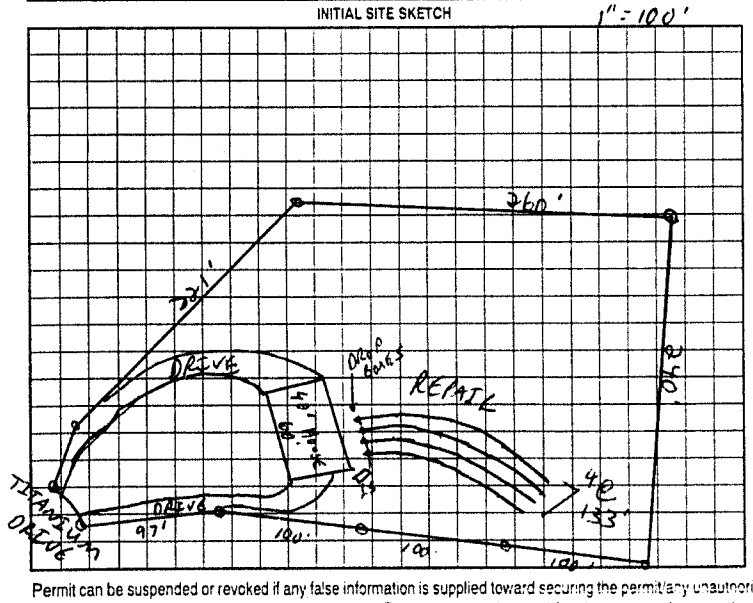

AS BUILT SKETCH

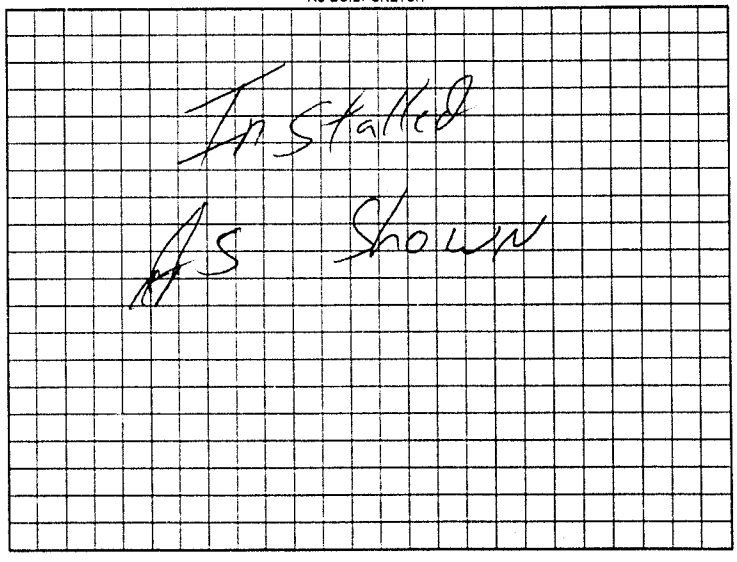

Permit can be suspended or revoked if any false information is supplied toward securing the permit/any unauthorized changes are made to the site any unauthorized changes are made in the installation of the system. Improvement Permit with plat valid without expiration. Improvement Permit with site plan valid for sixty months. Authorization to Construct is valid for a period equal to that of Improvement Permit – not to exceed sixty months

Signed: [signature] date 2-5-02 Installed by Chris Wagner

Improvement Permit by: C. Hyatt RS date 2/5/02 Operation Permit by: William O. Johnson date 5/28/02

Authorization to Construct by: C. Hyatt RS date 2/5/02 Existing System Inspection by: date

HEALTH DEPT COPY WHITE OWNER COPY (FINAL) YELLOW OWNER COPY (INITIAL) PINK