This permit was previously issued permit dated 10/24/01

IREDELL COUNTY HEALTH DEPARTMENT

STATESVILLE 704-878-5305 CI MOORESVILLE 704-664-5281

IMPROVEMENT PERMIT / AUTHORIZATION TO CONSTRUCT / OPERATION PERMIT / EXISTING SYSTEM INSPECTION

PERMIT# 102636 PIN# 4705-95-2406 DATE 7/9/04

OWNER OR CONTRACTOR Schultz Housing PHONE: Business (704) 902-1836 Home (704) 883-9997

ADDRESS 134 KOA Lane Statesville, NC 28677

LOCATION 64 West (L) Lippus Farm (L) Stones Edge (L) Gemstone (R) 2nd on Rgt before Pond

SUBDIVISION Stonesedge BLOCK / SECTION LOT 97 LOT AREA .483 Ac SITE CLASS. PS DESIGN FLOW 360 L.T.A.R. .30 gpd

Septic Tank: 4000 Gallons; STB 1012 Date 2-19-04

Pump Tank: Gallons; PT Date

Pump Make: Model Eg 66 Serial No.

Nitrification Field: No Fields 1 Square Feet 1200 Linear Feet 300

No Lines 3 Trench Width 36" Max Trench Bottom Depth 36" Gravel Depth N/A

☒ New System ☐ Repair System Type: I, II, III, IV, V, VI

System Description: Gravity 25% Reduction

Repair System Description: LP Panel Repair

Maintenance Agreement Required: ☐ Yes ☒ No

☒ House/Mod. Home ☐ Mobile Home ☐ Business ☐ Other

No. Bedrooms 3 No. Bathrooms 2 No. Employees

☐ Slab ☒ Crawl Space ☐ Basement w/plumbing ☐ Basement wo/plumbing


Water Supply: ☐ Individual ☒ Public ☐ Community

Comments:/Conditions: (1) Install lines on Contour


Comments:/Conditions:

- Tuff - Tite Filter + ST Marker Installed
- 48 Infiltrator Chamber Installed.

INITIAL SITE SKETCH

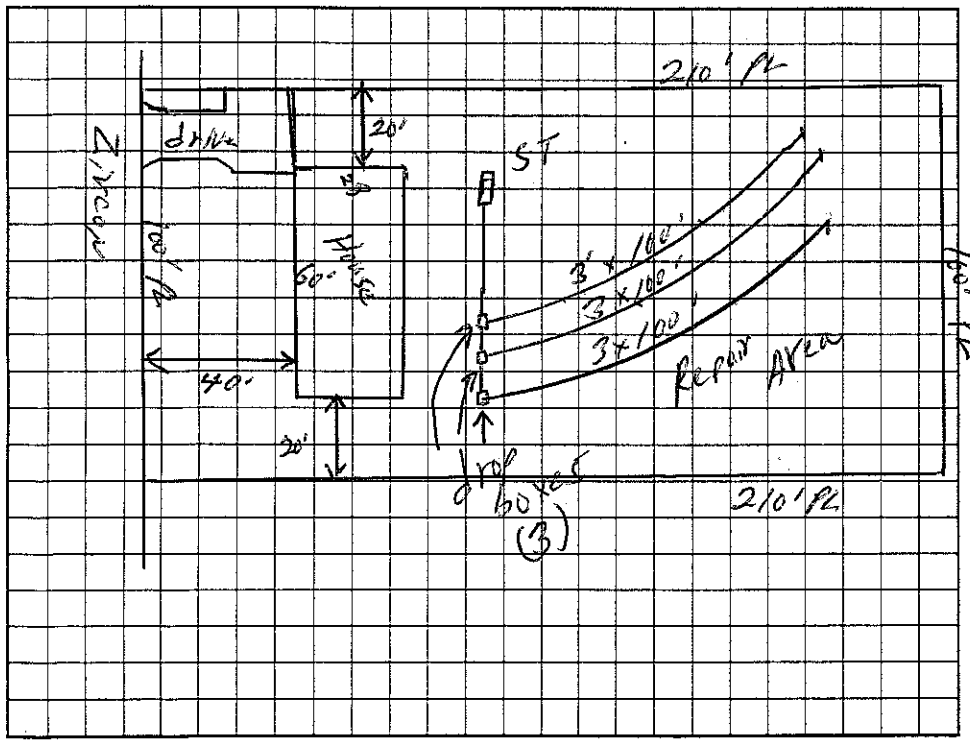

AS BUILT SKETCH

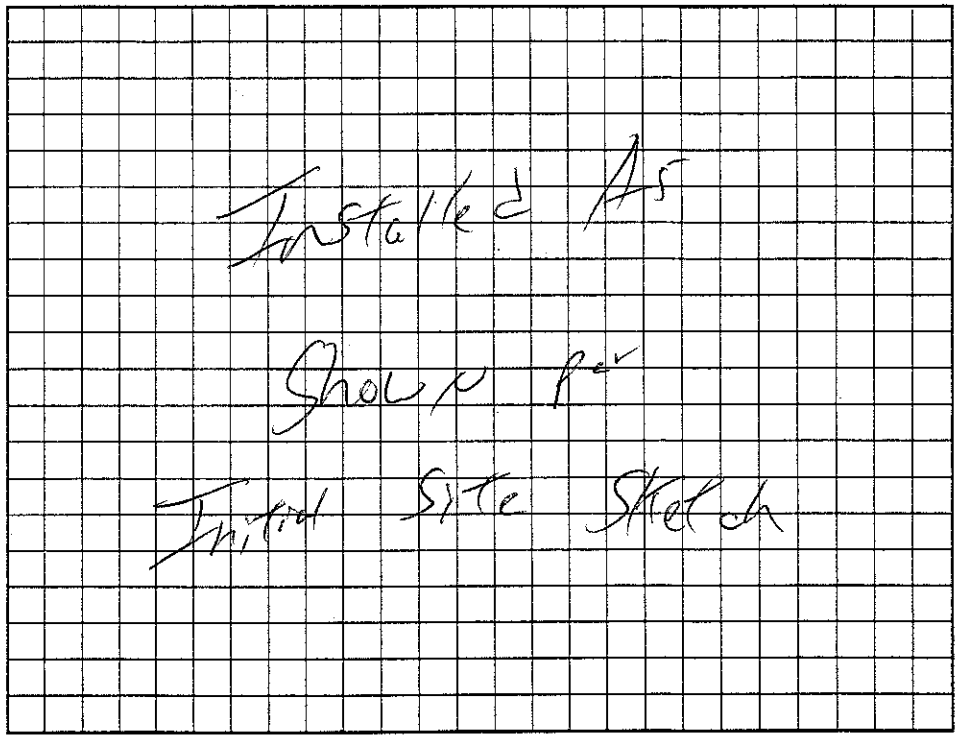

Permit can be suspended or revoked if any false information is supplied toward securing the permit/any unauthorized changes are made to the site/any unauthorized changes are made in the installation of the system. Improvement Permit with plat valid without expiration. Improvement Permit with site plan valid for sixty months. Authorization to Construct is valid for a period equal to that of Improvement Permit – not to exceed sixty months.

Signed: Sarah Lundy date 7/12/04

Improvement Permit by: William O. Johnson date 7/9/04

Authorization to Construct by: William O. Johnson date 7/9/04

Installed by: A-1 Backhoe

Operation Permit by: William O. Johnson date 9/14/04

Existing System Inspection by: date

HEALTH DEPT. COPY: WHITE OWNER COPY (FINAL): YELLOW OWNER COPY (INITIAL): PINK