IREDELL COUNTY HEALTH DEPARTMENT

STATESVILLE 704-878-5305 CI MOORESVILLE 704-664-5281

IMPROVEMENT PERMIT / AUTHORIZATION TO CONSTRUCT / OPERATION PERMIT / EXISTING SYSTEM INSPECTION

PERMIT# 102630 PIN# ~~4705-85-8934.55~~ 4705-95-3798 DATE 10/17/01

OWNER OR CONTRACTOR JOHN CRAVER PHONE: Business 663-2200 Home

ADDRESS 130 LAZY LANE - MOORESVILLE NC 28117

LOCATION HWY 64 WEST - TL LIPPARD FARM - TL STONESEDGE - TL GEMSTONE - TR ZIRCON - TL TITANIUM - 2nd LOT ON LT

SUBDIVISION STONESEDGE BLOCK / SECTION LOT 53 LOT AREA .505 SITE CLASS. PS DESIGN FLOW 360 GPD L.T.A.R. .300 GPD/RT 2

Septic Tank: 1000 Gallons; STB 1012 Date 9-9-02
Pump Tank: Gallons; PT Date
Pump Make: Model Serial No.
Nitrification Field: No Fields 1 Square Feet 900 Linear Feet 300
No Lines 4@75' Trench Width 36" Max Trench Bottom Depth 36" Gravel Depth N/A

☑ New System ☐ Repair System Type: I, II, III, IV, V, VI
System Description: GRAVITY 25% REDUCTION LD PANEL
Repair System Description:
Maintenance Agreement Required: ☐ Yes ☑ No

☑ House/Mod. Home No. Bedrooms 3
☐ Mobile Home No. Bathrooms 3
☐ Business No. Employees
☐ Other


☐ Slab ☑ Crawl Space ☐ Basement w/plumbing ☐ Basement wo/plumbing

Water Supply:
☐ Individual
☑ Public
☐ Community

Comments:/Conditions:

Comments:/Conditions: TUFF-TITE FILTERS + Septic Tank Markers Installed
- 48 Infiltrators Installed

INITIAL SITE SKETCH 1" = 50'

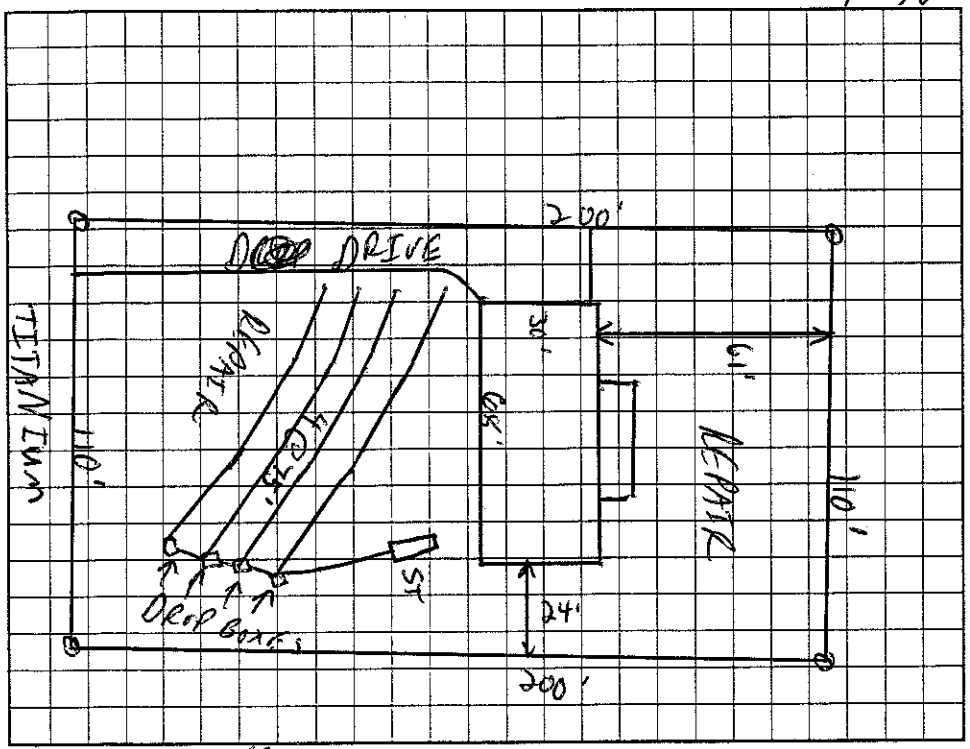

AS BUILT SKETCH

Installed As Shown Per Initial Site Sketch

Permit can be suspended or revoked if any false information is supplied toward securing the permit/any unauthorized changes are made to the site/any unauthorized changes are made in the installation of the system. Improvement Permit with plat valid without expiration. Improvement Permit with site plan valid for sixty months. Authorization to Construct is valid for a period equal to that of Improvement Permit – not to exceed sixty months.

Signed: date

Improvement Permit by: C. [illegible] RS date 10/17/01

Authorization to Construct by: William O. Johnson date 4/7/03

Installed by: A-1 Backhoe

Operation Permit by: William O. Johnson date 4/30/03

Existing System Inspection by: date

HEALTH DEPT. COPY: WHITE OWNER COPY (FINAL): YELLOW OWNER COPY (INITIAL): PINK