This permit voids previously issued permit dated 11/21/01.

IREDELL COUNTY HEALTH DEPARTMENT

STATESVILLE 704-878-5305 MOORESVILLE 704-664-5281

IMPROVEMENT PERMIT / AUTHORIZATION TO CONSTRUCT / OPERATION PERMIT / EXISTING SYSTEM INSPECTION

PERMIT# 103509 PIN# ~~4905-86-6304~~ 4705-95-4415 DATE 3/31/03

OWNER OR CONTRACTOR Johnny Craver PHONE: Business (704) 872-4644 Home

ADDRESS 1270 North Side Drive Statesville NC

LOCATION 64 West @ Lifford Farm, @ Stones Edge @ Cornstone @ Zircon on Right at end

SUBDIVISION Stones edge BLOCK / SECTION LOT 95 LOT AREA .513 Ac. SITE CLASS B5 DESIGN FLOW 360 L.T.A.R. .25 gpd/ft²

Septic Tank: 1,000 Gallons; STB 10/2 Date 12-10-02
Pump Tank: Gallons; PT Date
Pump Make: Model Serial No.
Nitrification Field: No Fields 1 Square Feet Linear Feet 360'
No Lines 4 Trench Width 36" Max Trench Bottom Depth 36" Gravel Depth NA

☒ New System ☐ Repair System Type: I ⓘ III, IV, V, VI
System Description: Gravity 25% Reduction
Repair System Description: Gravity 25% Reduction
Maintenance Agreement Required: ☐ Yes ☒ No

☐ House/Mod. ☐ Mobile Home ☐ Business ☐ Other
No. Bedrooms 3 No. Bathrooms 2 No. Employees


☐ Slab ☐ Crawl Space ☐ Basement w/plumbing ☐ Basement wo/plumbing

Water Supply: ☐ Individual ☒ Public ☐ Community


Comments:/Conditions: ① Remove Terraces + Berms ② Install Lines on Contour.

Comments:/Conditions: — Tuff-Tite filter & ST marker Installed

INITIAL SITE SKETCH 1" = 50'

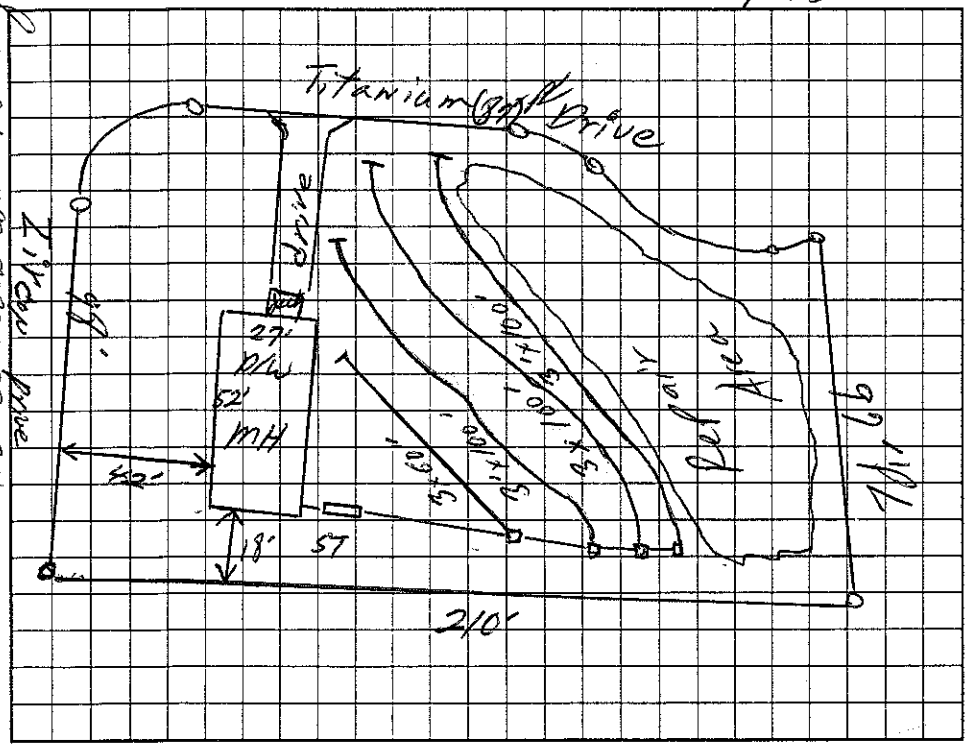

AS BUILT SKETCH

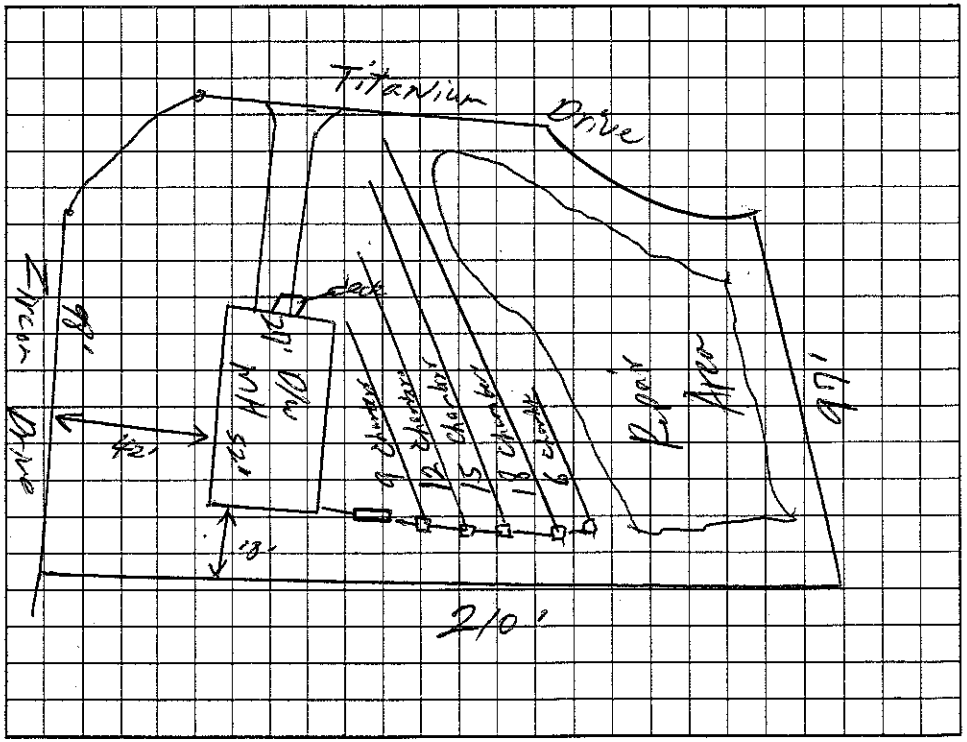

Trust Allison 182 Bircan Dr.

Permit can be suspended or revoked if any false information is supplied toward securing the permit/any unauthorized changes are made to the site/any unauthorized changes are made in the installation of the system. Improvement Permit with plat valid without expiration. Improvement Permit with site plan valid for sixty months. Authorization to Construct is valid for a period equal to that of Improvement Permit – not to exceed sixty months.

Signed: Donald C Smith date 14 April 03 Installed by: A-1 Backhoe

Improvement Permit by: William O. Johnson date 3/31/03 Operation Permit by: William O. Johnson date 6/20/03

Authorization to Construct by: William O. Johnson date 3/31/03 Existing System Inspection by: date

HEALTH DEPT. COPY: WHITE OWNER COPY (FINAL): YELLOW OWNER COPY (INITIAL): PINK