IREDELL COUNTY HEALTH DEPARTMENT

STATESVILLE 704-878-5305 ~~O~~ cat MOORESVILLE 704-664-5281

IMPROVEMENT PERMIT / AUTHORIZATION TO CONSTRUCT / OPERATION PERMIT / EXISTING SYSTEM INSPECTION

PERMIT# 106691 PIN# 4705954809 DATE 7/17/03

OWNER OR CONTRACTOR STONES EDGE INC PHONE: Business 663-2200 Home

ADDRESS 130 LAZY LANE MOORESVILLE NC 28117

LOCATION HWY 64- TL LEPPARD ~~FARM~~ FARM - TL STONES EDGE - TL CORNSTONE - TR ZERCON - TL TITANIUM - 3rd on LT

SUBDIVISION STONES EDGE BLOCK / SECTION LOT 54 LOT AREA .150 AC SITE CLASS. PS DESIGN FLOW 360GPD L.T.A.R. .360/ET2

Septic Tank: 1000 Gallons; STB 1017 Date 7-5-03

Pump Tank: Gallons; PT Date

Pump Make: Model Serial No.

Nitrification Field: No Fields 1 Square Feet 900 Linear Feet 300

No Lines 4@75' Trench Width 36" Max Trench Bottom Depth 36" Gravel Depth N/A

☑ New System ☐ Repair System Type: I, II, III, IV, V, VI

System Description: GRAVITY 25% REDUCTION

Repair System Description: SAME/ PANEL

Maintenance Agreement Required: ☐ Yes ☑ No

☑ House/Mod. Home No. Bedrooms 3

☐ Mobile Home No. Bathrooms 3

☐ Business No. Employees

☐ Other


☐ Slab ☑ Crawl Space ☐ Basement w/plumbing ☐ Basement wo/plumbing

Water Supply: ☐ Individual ☑ Public ☐ Community

Comments:/Conditions:

Comments:/Conditions: SEPTIC TANK WITH MARKER USING "TUF-TITE" FILTER INSTALLED

INITIAL SITE SKETCH 1" = 50'

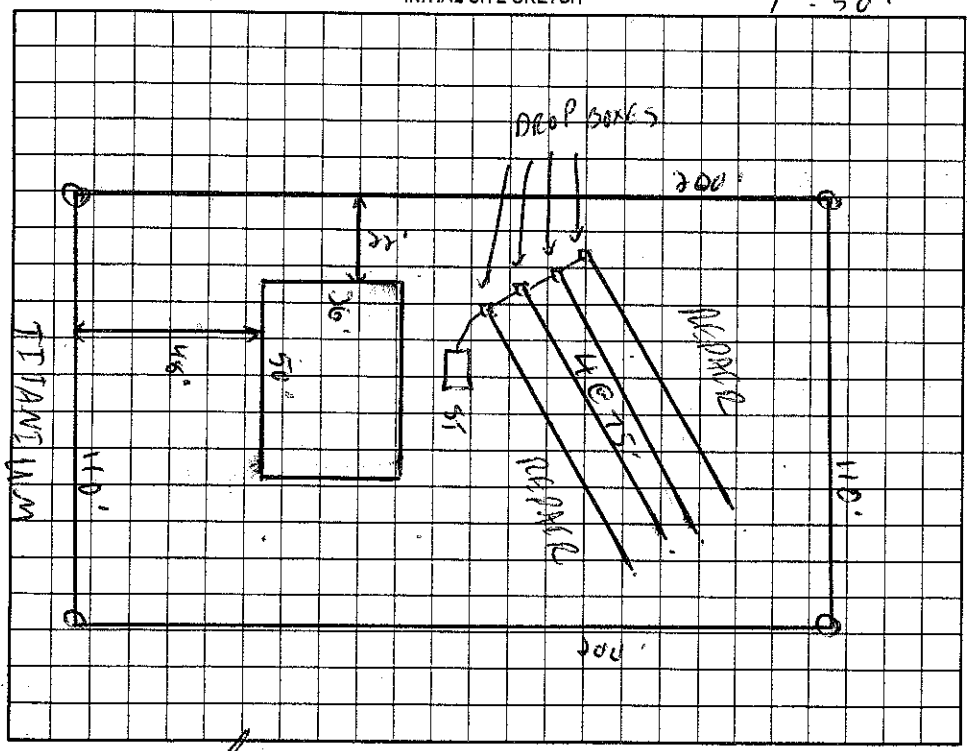

AS BUILT SKETCH

SYSTEM INSTALLED ACCORDING TO INITIAL SITE SKETCH USING 48 "INFILTRATOR" CHAMBERS

Permit can be suspended or revoked if any false information is supplied toward securing the permit/any unauthorized changes are made to the site/any unauthorized changes are made in the installation of the system. Improvement Permit with plat valid without expiration. Improvement Permit with site plan valid for sixty months. Authorization to Construct is valid for a period equal to that of Improvement Permit – not to exceed sixty months.

Signed: date 7-17-03 Installed by: Craig Thompson

Improvement Permit by: KS date 7/17/03 Operation Permit by: William A. Johnson date 8/14/03

Authorization to Construct by: KS date 7/17/03 Existing System Inspection by: date

HEALTH DEPT. COPY: WHITE OWNER COPY (FINAL): YELLOW OWNER COPY (INITIAL): PINK