IREDELL COUNTY HEALTH DEPARTMENT

STATESVILLE 704-878-5305 MOORESVILLE 704-664-5281

CI This permit replaces the one on 8/27/02.

IMPROVEMENT PERMIT / AUTHORIZATION TO CONSTRUCT / OPERATION PERMIT / EXISTING SYSTEM INSPECTION

PERMIT# 104426 PIN# 4705 95 62 35

OWNER OR CONTRACTOR STONES EDGE INC PHONE: Business 663-2220 Home DATE 8/30/02

ADDRESS 130 LAZY LANE MOORESVILLE

LOCATION 64W - TL LEGARD FARM - TL STONES EDGE - TL GEMSTONE - TR ZIRCON - TL TITANIUM AT END

SUBDIVISION STONES EDGE BLOCK / SECTION LOT 92 LOT AREA .73AC SITE CLASS CS DESIGN FLOW 360 GPD L.T.A.R. 360 GPD

Septic Tank: 1000 Gallons; STB 1012 Date 4-24-02
Pump Tank: Gallons; PT Date
Pump Make: Model Serial No
Nitrification Field: No Fields 1 Square Feet 900 Linear Feet 320
No Lines 3@100' Trench Width 36" Max Trench Bottom Depth 36" Gravel Depth n/a

☒ New System ☐ Repair System Type: I. II. (III) IV. V. VI
System Description: GRAVITY INNOVATIVE
Repair System Description: SAFE PUMP
Maintenance Agreement Required: ☐ Yes ☒ No
☐ Slab ☒ Crawl Space ☐ Basement w/plumbing ☐ Basement wo/plumbing


☒ House/Mod. Home No. Bedrooms 3
☐ Mobile Home No. Bathrooms 3
☐ Business No. Employees
☐ Other

Water Supply: ☐ Individual ☒ Public ☐ Community


Comments/Conditions:

Comments/Conditions: Tuff-Tite filter
St. marks Installed
-48 Infiltrators ~~Factory~~ Installed

INITIAL SITE SKETCH 1" = 50'

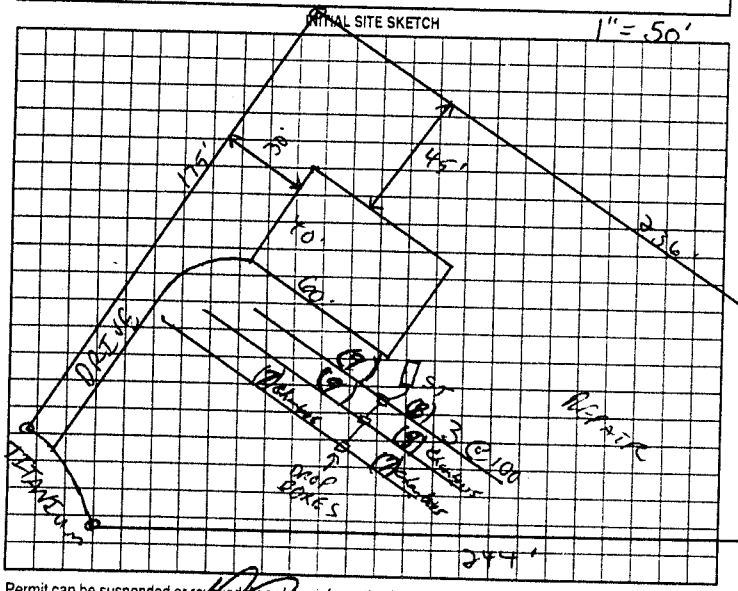

AS BUILT SKETCH

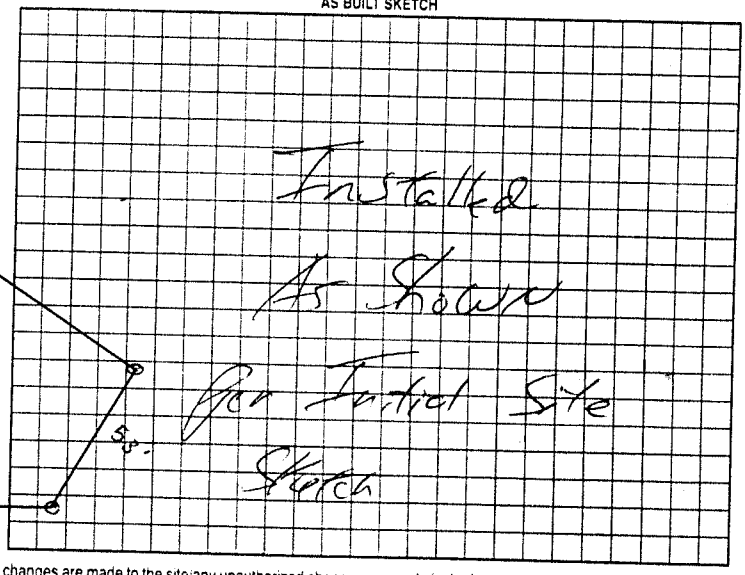

Permit can be suspended or revoked if any false information is supplied toward securing the permit/any unauthorized changes are made to the site/any unauthorized changes are made in the installation of the system. Improvement Permit with plat valid without expiration. Improvement Permit with site plan valid for sixty months. Authorization to Construct is valid for a period equal to that of Improvement Permit - not to exceed sixty months.

Signed: date 9-3-02 Installed by: Tommy Gathrens

Improvement Permit by: RS date 8/30/02 Operation Permit by: William O. Johnson date 9-19-02

Authorization to Construct by: RS date 8/30/02 Existing System Inspection by: date

HEALTH DEPT. COPY WHITE OWNER COPY (FINAL) YELLOW OWNER COPY (INITIAL) PINK