IREDELL COUNTY HEALTH DEPARTMENT

STATESVILLE 704-878-5305 MOORESVILLE 704-664-5281

IMPROVEMENT PERMIT / AUTHORIZATION TO CONSTRUCT / OPERATION PERMIT / EXISTING SYSTEM INSPECTION

PERMIT# 108428 PIN# 4705-95-6524 DATE 7/20/04

OWNER OR CONTRACTOR STONES EDGE INC PHONE: Business 663-2220 Home

ADDRESS 130 LAZY LN MOORESVILLE NC 28117

LOCATION 64 West - TL LEPPARD FARM - TL STONESEDGE - TL GEMSTONE - TR ZIRCON - STRAIGHT ACROSS ZIRCON ON JTANSON

SUBDIVISION STONES EDGE BLOCK / SECTION LOT 90 LOT AREA .505 SITE CLASS. PS DESIGN FLOW 480GPD L.T.A.R. .25GPD/FT2

Septic Tank: 1000 Gallons; STB 1012 Date 4-21-04
Pump Tank: 1000 Gallons; PT 17 Date 7-7-04
Pump Make: Gaulds Model WE05111H Serial No. G0460861
Nitrification Field: No Fields 1 Square Feet 1440 Linear Feet 480
No Lines 6@80' Trench Width 36" Max Trench Bottom Depth 30" Gravel Depth N/A

☑ New System ☐ Repair System Type: I, II, (III), IV, V, VI
System Description: PUMP 25% REDUCTION
Repair System Description: LP PANEL
Maintenance Agreement Required: ☐ Yes ☑ No

☑ House/Mod. Home No. Bedrooms 4
☐ Mobile Home No. Bathrooms 4
☐ Business No. Employees
☐ Other
☐ Slab ☑ Crawl Space ☐ Basement w/plumbing ☐ Basement wo/plumbing


Water Supply: ☐ Individual ☑ Public ☐ Community

Comments:/Conditions:


Comments:/Conditions:

Tuff Tite filter + ST Marker, 5 lines okay
-78 Infiltrator Chambers Installed 8/26/04
-Bottom (6th) line checked okay Pressure check ok 8/27/04

INITIAL SITE SKETCH 1"=50'

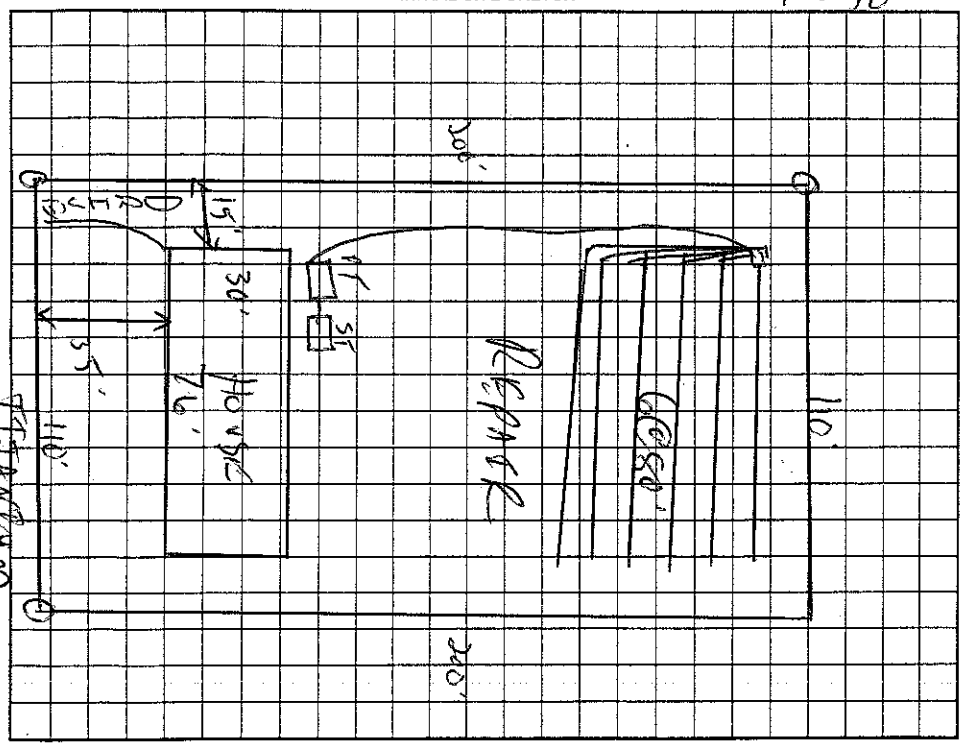

AS BUILT SKETCH

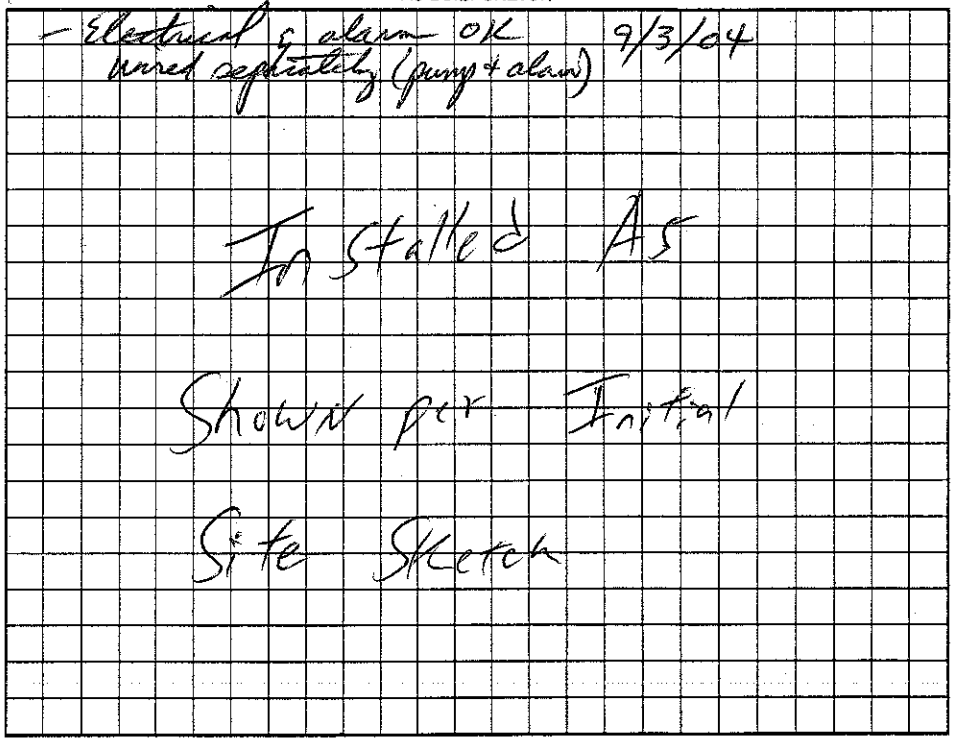

Permit can be suspended or revoked if any false information is supplied toward securing the permit/any unauthorized changes are made to the site/any unauthorized changes are made in the installation of the system. Improvement Permit with plat valid without expiration. Improvement Permit with site plan valid for sixty months. Authorization to Construct is valid for a period equal to that of Improvement Permit – not to exceed sixty months.

Signed: RM Hill date 8/4/04
Improvement Permit by: C. Mills RS date 7/20/04
Authorization to Construct by: C. Mills RS date 7/20/04

Installed by: Craig Thompson (8/27/04)
Operation Permit by: Christopher M Sherrill, PS date 9-3-04
Existing System Inspection by: date

HEALTH DEPT. COPY: WHITE OWNER COPY (FINAL): YELLOW OWNER COPY (INITIAL): PINK