IREDELL COUNTY HEALTH DEPARTMENT

STATESVILLE 704-878-5305 CJ 130.00 Paid MOORESVILLE 704-664-5281

IMPROVEMENT PERMIT / AUTHORIZATION TO CONSTRUCT / OPERATION PERMIT / EXISTING SYSTEM INSPECTION

PERMIT# 108427 PIN# 4705956635 DATE 7/19/04

OWNER OR CONTRACTOR STONES EDGE INN PHONE: Business 663-2220 Home

ADDRESS 130 LAZY LANE · MOORESVILLE NC 28117

LOCATION 64 West - TL LIPPARD FARM - TL STONES EDGE - TL HEMSTONE - TL ZERION - TL TINANDUM ON RT

SUBDIVISION STONES EDGE BLOCK / SECTION LOT 89 LOT AREA .50 AC SITE CLASS. OS DESIGN FLOW 450 GPD L.T.A.R. .3600/RT

Septic Tank: 1000 Gallons; STB 1012 Date 4-3-04

Pump Tank: 1000 Gallons; PT 171 Date 7-11-04

Pump Make: Model Serial No.

Nitrification Field: No Fields 1 Square Feet 1200 Linear Feet 400

No Lines 5 @ 80' Trench Width 36" Max Trench Bottom Depth 36" Gravel Depth N/A

☑ New System ☐ Repair System Type: I, II, III, IV, V, VI

System Description: PUMP 25% REDUCTION

Repair System Description: LP PANEL

Maintenance Agreement Required: ☐ Yes ☑ No

☑ House/Mod. Home No. Bedrooms 4

☐ Mobile Home No. Bathrooms 4

☐ Business No. Employees

☐ Other

☐ Slab ☑ Crawl Space ☐ Basement w/plumbing ☐ Basement wo/plumbing


Water Supply: ☐ Individual ☑ Public ☐ Community

Comments:/Conditions:

Comments:/Conditions: Tuff - Tite Filter & ST Marker Installed

- deck not installed As of 8/17/04
- Deck must be 5 ft From PT & Septic Tank

INITIAL SITE SKETCH 1" = 50'

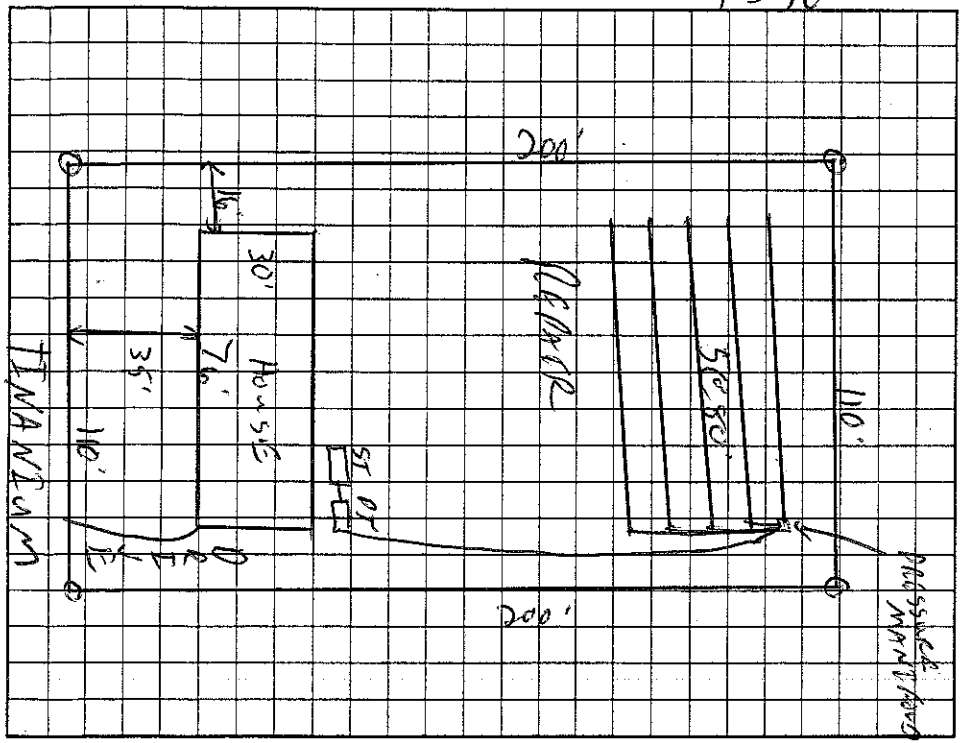

AS BUILT SKETCH

- Electrical & Alarm - ok'd, Pressure check - ok'd
- Pressure manifold complete.
- 6'x6' deck Installed on House

Installed As Shown per Initial Site Sketch

Permit can be suspended or revoked if any false information is supplied toward securing the permit/any unauthorized changes are made to the site/any unauthorized changes are made in the installation of the system. Improvement Permit with plat valid without expiration. Improvement Permit with site plan valid for sixty months. Authorization to Construct is valid for a period equal to that of Improvement Permit – not to exceed sixty months.

Signed: [signature] date 7/27/04

Improvement Permit by: [signature] date 7/19/04

Authorization to Construct by: [signature] date 7/19/04

Installed by: Craig Thompson (8/17/04)

Operation Permit by: William O. Johnson date 8/25/04

Existing System Inspection by: date

HEALTH DEPT. COPY: WHITE OWNER COPY (FINAL): YELLOW OWNER COPY (INITIAL): PINK