IREDELL COUNTY HEALTH DEPARTMENT

STATESVILLE 704-878-5305 MOORESVILLE 704-664-5281

IMPROVEMENT PERMIT / AUTHORIZATION TO CONSTRUCT / OPERATION PERMIT / EXISTING SYSTEM INSPECTION

CI

PERMIT# 108425 PIN# 4705 95 6857 DATE 10-27-05

OWNER OR CONTRACTOR Stones Edge PHONE: Business 704 663 2220 Home

ADDRESS 130 Titanium Dr.

LOCATION Hwy 90/64 to Lippard Farm Road - (R) on Stones Edge (L) on Gemstone (R) on Zircon Drive (L) on Titanium

SUBDIVISION Stones Edge BLOCK / SECTION LOT 87 LOT AREA .505 Ac SITE CLASS. PS DESIGN FLOW 360 L.T.A.R. .3

Septic Tank: 1000 Gallons; STB P 1012 Date 9/23/05

Pump Tank: 100 Gallons; PT PT 17 1000 Date 9/28/05

Pump Make: Gould Model 1/3 HP 1/60/115 Serial No. 1PWE03114

Nitrification Field: No Fields 1 Square Feet 1200 Linear Feet 300

No Lines 4 Trench Width 3 Max Trench Bottom Depth 36" Gravel Depth

[X] New System [ ] Repair System Type: I, II, (III), IV, V, VI

System Description: 25% Red. Pump to Pressure Man.

Repair System Description: 25% Red. Pump to Press. Man.

Maintenance Agreement Required: [ ] Yes [X] No

[ ] House/Mod. Home [X] Mobile Home [ ] Business [ ] Other

No. Bedrooms 3 No. Bathrooms No. Employees


[ ] Slab [ ] Crawl Space [ ] Basement w/plumbing [ ] Basement wo/plumbing

Water Supply: [ ] Individual [X] Public [X] Community

Comments:/Conditions:

Comments:/Conditions:
Yellow Filter

INITIAL SITE SKETCH

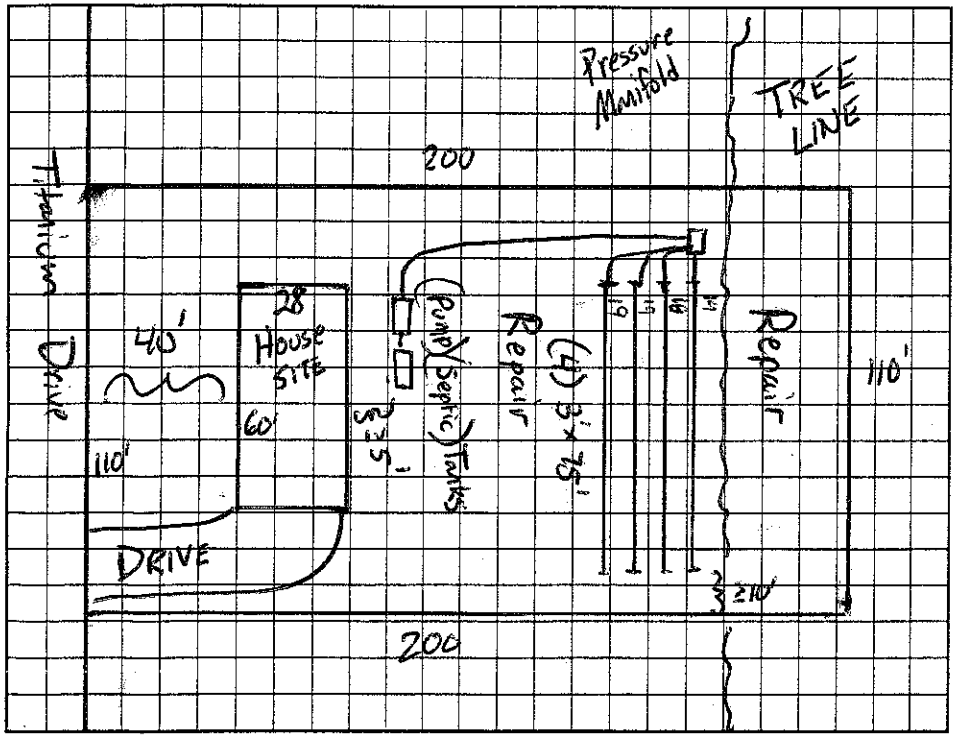

AS BUILT SKETCH

JAMES VAN PRESSURE LINES
LOWE VAN ELEVATION 1-20-06

Permit can be suspended or revoked if any false information is supplied toward securing the permit/any unauthorized changes are made to the site/any unauthorized changes are made in the installation of the system. Improvement Permit with plat valid without expiration. Improvement Permit with site plan valid for sixty months. Authorization to Construct is valid for a period equal to that of Improvement Permit – not to exceed sixty months.

Signed: date 10/1/05 Installed by: A-1 Backhoe

Improvement Permit by: James Lowe date 10-27-05 Operation Permit by: date 1-20-06

Authorization to Construct by: James Lowe date 10-27-05 Existing System Inspection by: date

HEALTH DEPT. COPY: WHITE OWNER COPY (FINAL): YELLOW OWNER COPY (INITIAL): PINK