IREDELL COUNTY HEALTH DEPARTMENT

STATESVILLE 704-878-5305 | 130.00 Paid | MOORESVILLE 704-664-5281

IMPROVEMENT PERMIT / AUTHORIZATION TO CONSTRUCT / OPERATION PERMIT / EXISTING SYSTEM INSPECTI

PERMIT# 108414 PIN# 4705956959 DATE 4/30/03

OWNER OR CONTRACTOR STONES EDGE INC PHONE: Business 663-2220 Home

ADDRESS 130 LAZY LANE MOORESVILLE NC 28117

LOCATION 64 W - TL CIPPARD FARM - TL STONES EDGE - TL GEMSTONE - TR ZIRCON - TL TITANIUM - LOT ON RT

SUBDIVISION STONES EDGE BLOCK / SECTION LOT 86 LOT AREA 1.591C SITE CLASS. PS DESIGN FLOW 480GPD L.T.A.R. .36PD/FT2

Septic Tank: 1000 Gallons; STB 1012 Date 8-30-02

Pump Tank: Gallons; PT Date

Pump Make: Model Serial No.

Nitrification Field: No Fields 1 Square Feet 1200 Linear Feet 400

No Lines 5 Trench Width 36" Max Trench Bottom Depth 36" Gravel Depth N/A

☑ New System ☐ Repair System Type: I, II, III, IV, V, VI

System Description: GRADE 25% REDUCTION

Repair System Description: CB PANEL

Maintenance Agreement Required: ☐ Yes ☑ No

☑ House/Mod. Home ☑ Mobile Home ☐ Business ☐ Other

No. Bedrooms 4 No. Bathrooms 4 No. Employees

Water Supply: ☐ Individual ☑ Public ☐ Community


☐ Slab ☑ Crawl Space ☐ Basement w/plumbing ☐ Basement wo/plumbing

Comments:/Conditions:

Comments:/Conditions:

- Taff-Tite Filter + S.T. marks installed
- 64 INFILTRATOR Chambers Installed
(6 chambers, 12, 15, 15, 16 chambers 1st Line (2nd) (3rd) (4th) (5th) Line)

INITIAL SITE SKETCH 1"=50'

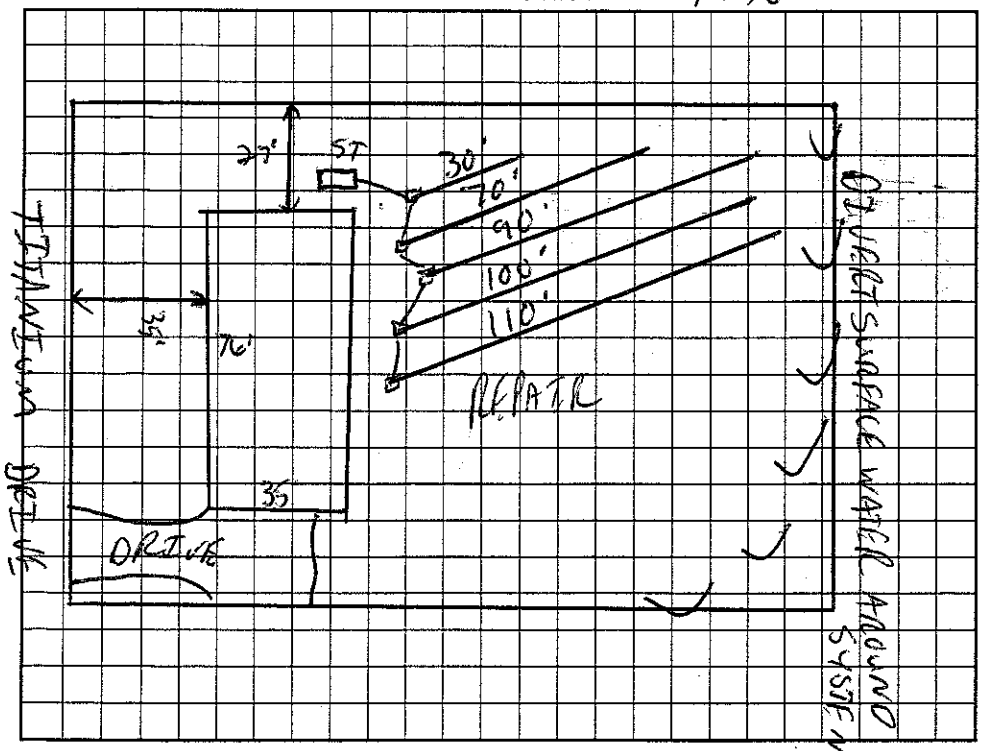

AS-BUILT SKETCH

Installed as Shown

Per Initial Site Sketch

Permit can be suspended or revoked if any false information is supplied toward securing the permit/any unauthorized changes are made to the site/any unauthorized changes are made in the installation of the system. Improvement Permit with plat valid without expiration. Improvement Permit with site plan valid for sixty months. Authorization to Construct is valid for a period equal to that of Improvement Permit – not to exceed sixty months.

Signed: Donald A Smith date 1 May 03 Installed by: A-1 Backhoe

Improvement Permit by: C. Gray RS date 4/30/03 Operation Permit by: William A. Johnson date 5/2/03

Authorization to Construct by: C. Gray RS date 4/30/03 Existing System Inspection by: date

HEALTH DEPT. COPY: WHITE OWNER COPY (FINAL): YELLOW OWNER COPY (INITIAL): PINK