IREDELL COUNTY HEALTH DEPARTMENT

STATESVILLE 704-878-5305 (C) 130.00 Paid MOORESVILLE 704-664-5281

IMPROVEMENT PERMIT / AUTHORIZATION TO CONSTRUCT / OPERATION PERMIT / EXISTING SYSTEM INSPECTION

PERMIT# 105278 PIN# 4705 96 2013 DATE 1/20/05

OWNER OR CONTRACTOR STONES EDGE INC. PHONE: Business 663-2220 Home

ADDRESS ~~122 PEARL~~ 130 LAZY LANE MOORESVILLE

LOCATION 64 WEST - TL LEOPARD FARM - TL STONES EDGE - TL TURNSTONE - TR ZIRCON - TL PERIDOT - ON RT

SUBDIVISION STONES EDGE BLOCK / SECTION LOT 48 LOT AREA .642 AC SITE CLASS RS DESIGN FLOW 450GPD L.T.A.R. .3640/FT2

Septic Tank: 1000 Gallons; STB 1012 Date 7-16-04
Pump Tank: Gallons; PT Date
Pump Make: Model Serial No.
Nitrification Field: No Fields 1 Square Feet 1200 Linear Feet 400
No Lines 4 Trench Width 36" Max Trench Bottom Depth 36"

☑ New System ☐ Repair System Type: I, II, III, IV, V, VI
System Description: GRAVITY 25% REDUCTION
Repair System Description: LI PANEL
Maintenance Agreement Required: ☐ Yes ☑ No

☑ House/Mod. Home No. Bedrooms 4
☐ Mobile Home No. Bathrooms 4
☐ Business No. Employees
☐ Other


Gravel Depth N/A ☐ Slab ☑ Crawl Space ☐ Basement w/plumbing ☐ Basement wo/plumbing

Water Supply: ☐ Individual ☑ Public ☐ Community


Comments:/Conditions:

Comments:/Conditions: ① SEPTIC TANK WITH MARKER INSTALLED USING "TUFFTITE" FILTER ② SYSTEM ALTERED AS SHOWN WITHOUT PRIOR HEALTH DEPT. APPROVAL ③ SYSTEM INSTALLED DURING PERIOD OF WET SOIL CONDITIONS.

INITIAL SITE SKETCH 1"=50'

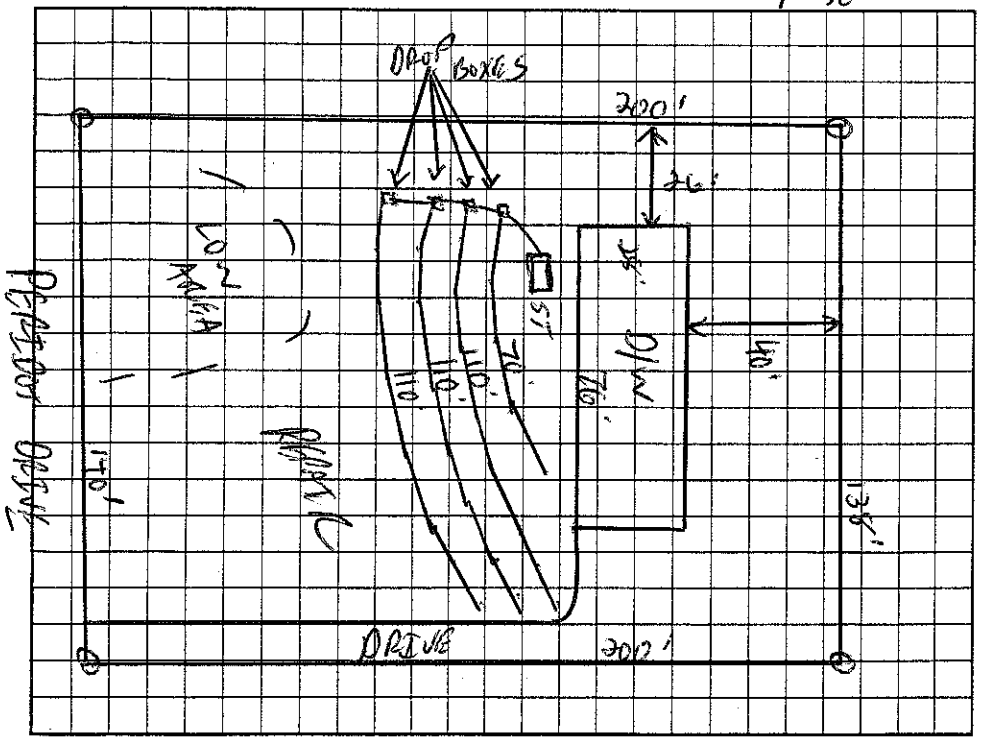

AS BUILT SKETCH

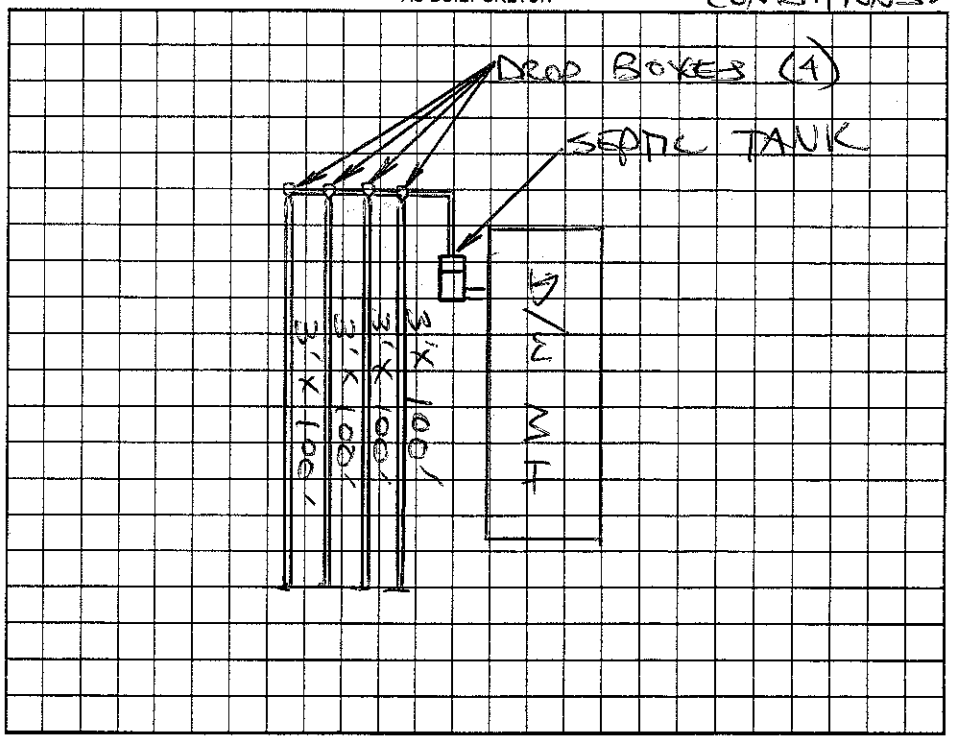

Permit can be suspended or revoked if any false information is supplied toward securing the permit/any unauthorized changes are made to the site/any unauthorized changes are made in the installation of the system. Improvement Permit with plat valid without expiration. Improvement Permit with site plan valid for sixty months. Authorization to Construct is valid for a period equal to that of Improvement Permit – not to exceed sixty months.

Signed: Lina Johnston date 1-21-05 Installed by: A-1 BACKHOE

Improvement Permit by: RS date 1/20/05 Operation Permit by: STEVE HEDRICK date 2-1-05

Authorization to Construct by: RS date 1/20/05 Existing System Inspection by: date

HEALTH DEPT. COPY: WHITE OWNER COPY (FINAL): YELLOW OWNER COPY (INITIAL): PINK