IREDELL COUNTY HEALTH DEPARTMENT

STATESVILLE 704-878-5305 (c1) MOORESVILLE 704-664-5281

IMPROVEMENT PERMIT / AUTHORIZATION TO CONSTRUCT / OPERATION PERMIT / EXISTING SYSTEM INSPECTION

PERMIT# ~~12569~~ ~~TO 5247~~ PIN# 4705 96 2556 DATE 11/24/04

OWNER OR CONTRACTOR STONES EDGE INC. PHONE: Business 663-2220 Home

ADDRESS 130 LAZY LANE - MOORESVILLE NC 28117

LOCATION 64 WEST - TL LIPPARD FARM - TL STONESEDGE - TL HEMSTONE - TR LEFT ON T - TL PROJECT - 8TH ON RT

SUBDIVISION STONESEDGE BLOCK / SECTION 1 LOT 44 LOT AREA .50 AC SITE CLASS. PS DESIGN FLOW 450 GPD L.T.A.R. .3606/F2

Septic Tank: 1000 Gallons; STB 1012 Date 6-16-04

Pump Tank: Gallons; PT Date

Pump Make: Model Serial No.

Nitrification Field: No Fields 1 Square Feet 1200 Linear Feet 400

No Lines 5 @ 80' Trench Width 36" Max Trench Bottom Depth 36" Gravel Depth N/A

☑ New System ☐ Repair System Type: I, II, (III) IV, V, VI

System Description: GRAVITY 25% REDUCTION

Repair System Description: LD CANAL

Maintenance Agreement Required: ☐ Yes ☐ No

☐ ~~House/Mod. Home~~ No. Bedrooms 4

☐ Mobile Home No. Bathrooms 4

☐ Business No. Employees

☐ Other


☐ Slab ☑ Crawl Space ☐ Basement w/plumbing ☐ Basement wo/plumbing

Water Supply: ☐ Individual ☑ ~~Public~~ ☐ Community

Comments:/Conditions:

Comments:/Conditions: SEPTIC TANK WITH MARKER INSTALLED USING "TUFTITE" FILTER

INITIAL SITE SKETCH 1"=50'

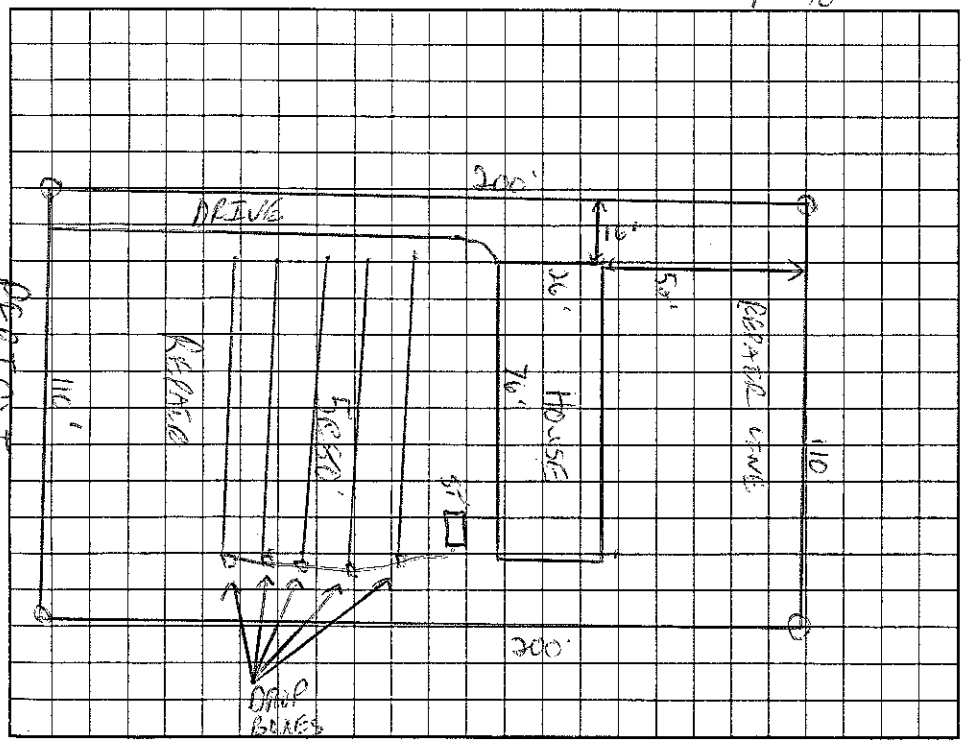

AS BUILT SKETCH

SYSTEM INSTALLED ACCORDING TO INITAL SITE SKETCH

Permit can be suspended or revoked if any false information is supplied toward securing the permit/any unauthorized changes are made to the site/any unauthorized changes are made in the installation of the system. Improvement Permit with plat valid without expiration. Improvement Permit with site plan valid for sixty months. Authorization to Construct is valid for a period equal to that of Improvement Permit – not to exceed sixty months.

Signed: Lisa Johnston date 11/24/04

Improvement Permit by: C. M. S date 11/24/04

Authorization to Construct by: C. M. S date 11/24/04

Installed by: A-1 BACKHOE

Operation Permit by: STEVE HEDRICK date 12-3-04

Existing System Inspection by: date

HEALTH DEPT. COPY: WHITE OWNER COPY (FINAL): YELLOW OWNER COPY (INITIAL): PINK