IREDELL COUNTY HEALTH DEPARTMENT

STATESVILLE 704-878-5305 MOORESVILLE 704-664-5281

IMPROVEMENT PERMIT / AUTHORIZATION TO CONSTRUCT / OPERATION PERMIT / EXISTING SYSTEM INSPECTION

PERMIT# 105 251 PIN# 4705 46 2657 DATE 7/22/02

OWNER OR CONTRACTOR JOHN CRAVER PHONE: Business 663-2220 Home

ADDRESS 130 LAZY LANE MOORESVILLE NC 28117

LOCATION 64W - TL LIPPARD FARM - TL STONES EDGE - TL GEMSTONE - TR ZIRCON - TL PERIDOT - ON RT

SUBDIVISION STONES EDGE BLOCK / SECTION LOT 43 LOT AREA .483 SITE CLASS PS DESIGN FLOW 360GPD L.T.A.R. 360 SQ FT

Septic Tank: 1000 Gallons: STB 1012 Date 5-4-02
Pump Tank: Gallons: PT Date
Pump Make: Model Serial No.
Nitrification Field: No Fields 1 Square Feet 1200 Linear Feet 400
No Lines 6 Trench Width 36" Max Trench Bottom Depth 36" Gravel Depth 12"

☑ New System ☐ Repair System Type: I (II) III IV V VI
System Description: GRAVITY CONVENTIONAL
Repair System Description: CP PANEL
Maintenance Agreement Required: ☐ Yes ☑ No
☐ Slab ☑ Crawl Space ☐ Basement w/plumbing ☐ Basement wo/plumbing


☑ House/Mod. Home No. Bedrooms 3
☐ Mobile Home No. Bathrooms 3
☐ Business No. Employees
☐ Other

Water Supply: ☐ Individual ☐ ~~Public~~ ☐ Community

Comments/Conditions:

Comments/Conditions: POLYLOK FILTER & MARKER INSTALLED AS SHOWN

INITIAL SITE SKETCH 1" = 50'

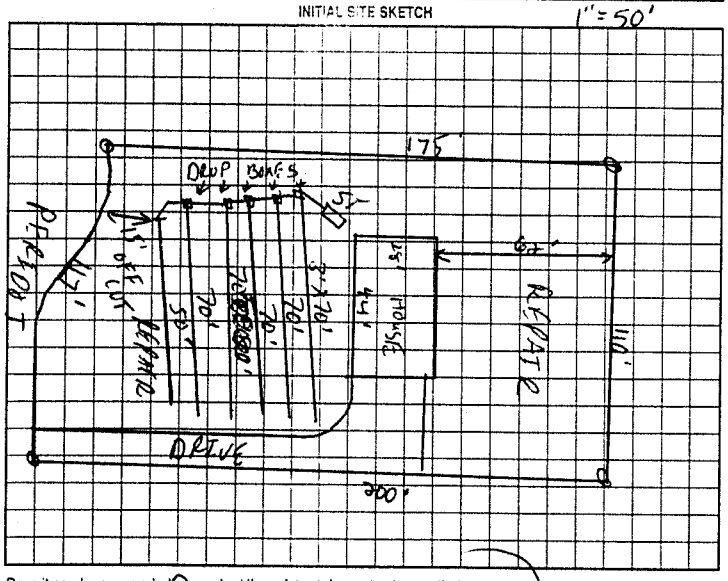

AS BUILT SKETCH

Permit can be suspended or revoked if any false information is supplied toward securing the permit/any unauthorized changes are made to the site/any unauthorized changes are made in the installation of the system. Improvement Permit with plat valid without expiration. Improvement Permit with site plan valid for sixty months. Authorization to Construct is valid for a period equal to that of Improvement Permit – not to exceed sixty months.

Signed: Dennis Dallik date 7-22-02 Installed by: A-1 BACKHOE

Improvement Permit by: [signature] RS date 7/22/02 Operation Permit by: [signature] RS date 07-25-02

Authorization to Construct by: [signature] RS date 7/22/02 Existing System Inspection by: date

HEALTH DEPT COPY: WHITE OWNER COPY (FINAL): YELLOW OWNER COPY (INITIAL): PINK