IREDELL COUNTY HEALTH DEPARTMENT

STATESVILLE 704-878-5305 25.00 Pd MOORESVILLE 704-664-5281

IMPROVEMENT PERMIT / AUTHORIZATION TO CONSTRUCT / OPERATION PERMIT / EXISTING SYSTEM INSPECTION

PERMIT# 104516 PIN# 4705 96 2869 DATE 4/19/02

OWNER OR CONTRACTOR STONES EDGE INC. PHONE. Business 663-2220 Home

ADDRESS 130 LAZY LANE MOORESVILLE NC 28117

LOCATION 64W - TL LIPPARO FARM - TL STONES EDGE - TL GEMSTONE - TR ZERCON - TL PARLDOT AT END

SUBDIVISION STONES EDGE BLOCK / SECTION LOT 42 LOT AREA 1.58 SITE CLASS PS DESIGN FLOW 480GPD L.T.A.R. 3000/FT

Septic Tank: 1000 Gallons: STB 1-18-02 Date 10/2

Pump Tank: Gallons: PT Date

Pump Make: Model Serial No.

Nitrification Field: No Fields 1 Square Feet 1605 Linear Feet 535

No Lines 5@107' Trench Width 36" Max Trench Bottom Depth 36" Gravel Depth 12"

☑ New System ☐ Repair System Type. I. II. III. IV. V. VI

System Description: GRAVITY CONVENTIONAL

Repair System Description: PUMP CONVENTIONAL

Maintenance Agreement Required: ☐ Yes ☑ No

☑ House/Mod. Home No. Bedrooms 4

☐ Mobile Home No. Bathrooms 4

☐ Business No Employees

☐ Other


☐ Slab ☑ Crawl Space ☐ Basement w/plumbing ☐ Basement wo/plumbing

Water Supply: ☐ Individual ☑ Public ☐ Community


Comments/Conditions:

Comments/Conditions: - Polylok Filter Installed
- Septic Tank marker Installed

INITIAL SITE SKETCH

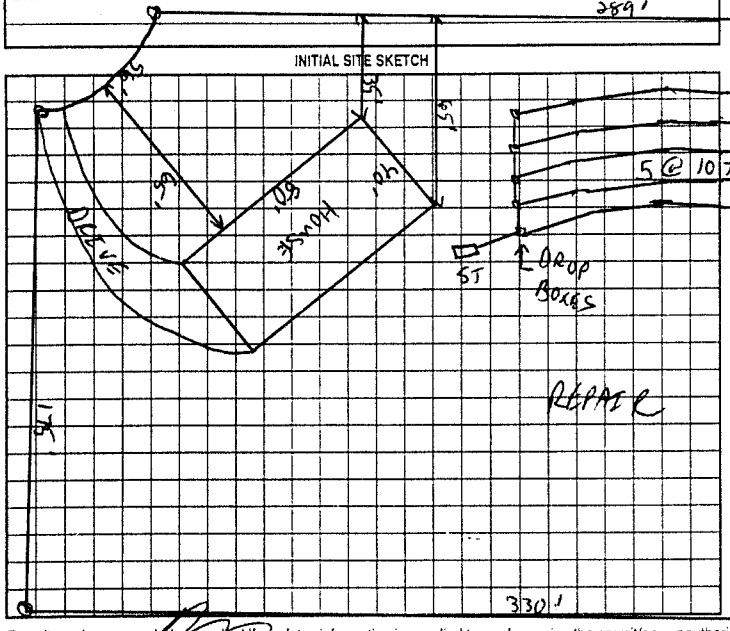

AS BUILT SKETCH

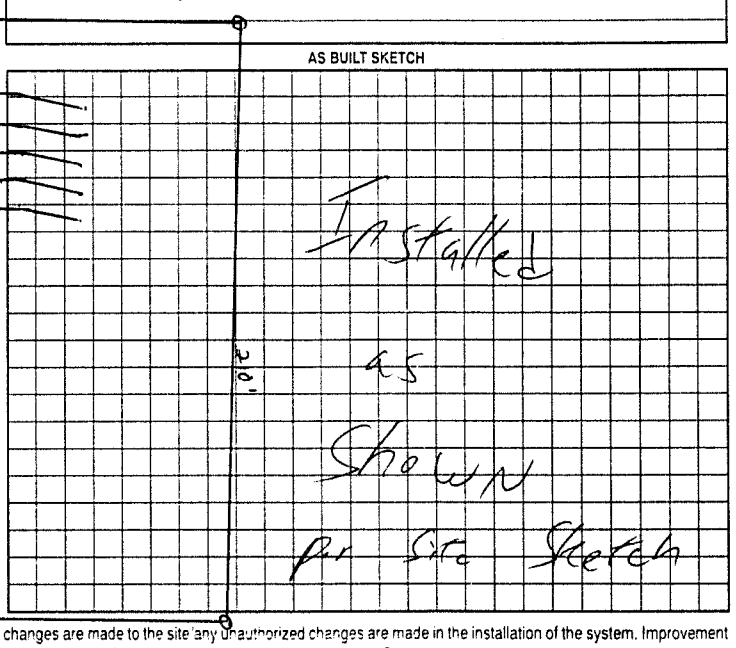

Permit can be suspended or revoked if any false information is supplied toward securing the permit/any unauthorized changes are made to the site/any unauthorized changes are made in the installation of the system. Improvement Permit with plat valid without expiration. Improvement Permit with site plan valid for sixty months. Authorization to Construct is valid for a period equal to that of Improvement Permit – not to exceed sixty months.

Signed: date 4/19/02 Installed by: Craig Thompson

Improvement Permit by: C. Hix KS date 4/19/02 Operation Permit by: William O Johnson date 5/24/02

Authorization to Construct by: C. Hix KS date 4/19/02 Existing System Inspection by: date

HEALTH DEPT. COPY WHITE OWNER COPY (FINAL) YELLOW OWNER COPY (INITIAL) PINK