This permit voids permit #10692. CI

IREDELL COUNTY HEALTH DEPARTMENT

STATESVILLE 704-878-5305 MOORESVILLE 704-664-5281

IMPROVEMENT PERMIT / AUTHORIZATION TO CONSTRUCT / OPERATION PERMIT / EXISTING SYSTEM INSPECTION

PERMIT# 120404 PIN# 4705-96-4000 DATE 6/14/04

OWNER OR CONTRACTOR Schult Housing PHONE: Business (704) 895-4622 Home

ADDRESS 137 KOA Ln Statesville N.C. 28677

LOCATION 64 W, (L) Lippard Farm Rd, (R) Stonesedge, (L) Gemstone (R) Zinn, (L) Titanium Lot on Left

SUBDIVISION Stonesedge BLOCK / SECTION LOT 55 LOT AREA .505 Ac SITE CLASS. B3 DESIGN FLOW 480 L.T.A.R. .30 spd

Septic Tank: 1,000 Gallons; STB 1012 Date 2-8-04
Pump Tank: Gallons; PT Date
Pump Make: Model Eq to Serial No.
Nitrification Field: No Fields 1 Square Feet 1600 Linear Feet 400
No Lines 4 @ 100' Trench Width 36" Max Trench Bottom Depth 36" Gravel Depth N/A

☒ New System ☐ Repair System Type: I, II, (III), IV, V, VI
System Description: Gravity 25% Reduction
Repair System Description: LP Pond Block
Maintenance Agreement Required: ☐ Yes ☒ No


☒ House/Mod. Home No. Bedrooms 4
☐ Mobile Home No. Bathrooms
☐ Business No. Employees
☐ Other
☐ Slab ☒ Crawl Space ☐ Basement w/plumbing ☐ Basement wo/plumbing

Water Supply: ☐ Individual ☒ Public ☐ Community

Comments:/Conditions:

Comments:/Conditions:
- Tuff Tite filter + S.T. marker Installed
- 56 Infiltrator Chambers Installed

INITIAL SITE SKETCH 1"=50'

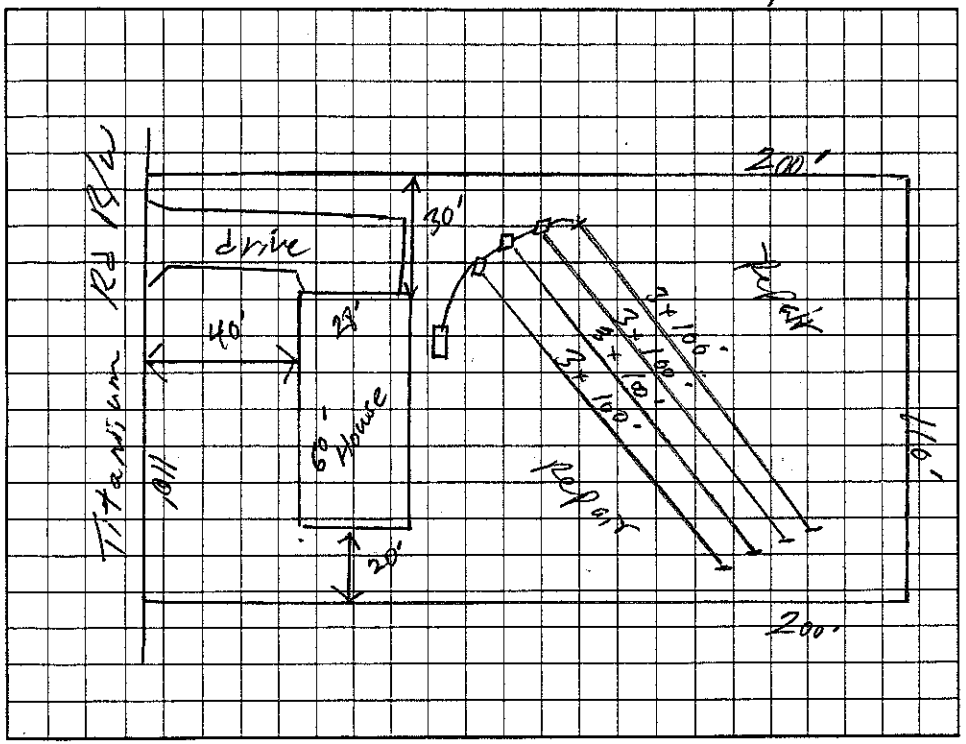

AS BUILT SKETCH

Installed As Shown for Initial Site Sketch

Permit can be suspended or revoked if any false information is supplied toward securing the permit/any unauthorized changes are made to the site/any unauthorized changes are made in the installation of the system. Improvement Permit with plat valid without expiration. Improvement Permit with site plan valid for sixty months. Authorization to Construct is valid for a period equal to that of Improvement Permit – not to exceed sixty months.

Signed: Sarah Lundy ADC date

Improvement Permit by: William O. Johnson date 6/14/04

Authorization to Construct by: William O. Johnson date 6/14/04

Installed by: A-1 Back hoe

Operation Permit by: William O. Johnson date 7/14/04

Existing System Inspection by: date

HEALTH DEPT. COPY: WHITE OWNER COPY (FINAL): YELLOW OWNER COPY (INITIAL): PINK