IREDELL COUNTY HEALTH DEPARTMENT

STATESVILLE 704-878-5305 cI 130.00 Paid MOORESVILLE 704-664-5281

IMPROVEMENT PERMIT / AUTHORIZATION TO CONSTRUCT / OPERATION PERMIT / EXISTING SYSTEM INSPECTION

PERMIT# 106698 PIN# 4705 96 4767 DATE 3/24/03

OWNER OR CONTRACTOR STONES EDGE INC PHONE: Business 663-2200 Home

ADDRESS 130 LAZY LANE MOORESVILLE NC 28117

LOCATION 64 W - TL LIPPARD FARM - TL STONES EDGE - TL GEMSTONE - TR ZIRCON - TL TITANIUM ON LT

SUBDIVISION STONES EDGE BLOCK / SECTION LOT 62 LOT AREA .505 AC SITE CLASS PS DESIGN FLOW 360GPD L.T.A.R. .36 GPD/FT²

Septic Tank: 1000 Gallons; STB 1012 Date 8-12-02
Pump Tank: Gallons; PT Date
Pump Make: Model Serial No.
Nitrification Field: No Fields 1 Square Feet 900 Linear Feet 300
No Lines 4@75' Trench Width 36" Max Trench Bottom Depth 36" Gravel Depth N/A

☑ New System ☐ Repair System Type: I, II, III, IV, V, VI
System Description: GRAVITY 25% REDUCTION
Repair System Description: SAME
Maintenance Agreement Required: ☐ Yes ☑ No


☑ House/Mod. Home No. Bedrooms 3
☐ Mobile Home No. Bathrooms 3
☐ Business No. Employees
☐ Other
☐ Slab ☑ Crawl Space ☐ Basement w/plumbing ☐ Basement wo/plumbing

Water Supply: ☐ Individual ☑ Public ☐ Community

Comments:/Conditions:

Comments:/Conditions: Tuff-Tite Filter & ST marker Installed
EZ-Lay Installed 300FT
(70, 70, 80, 80)

INITIAL SITE SKETCH 1" = 50'

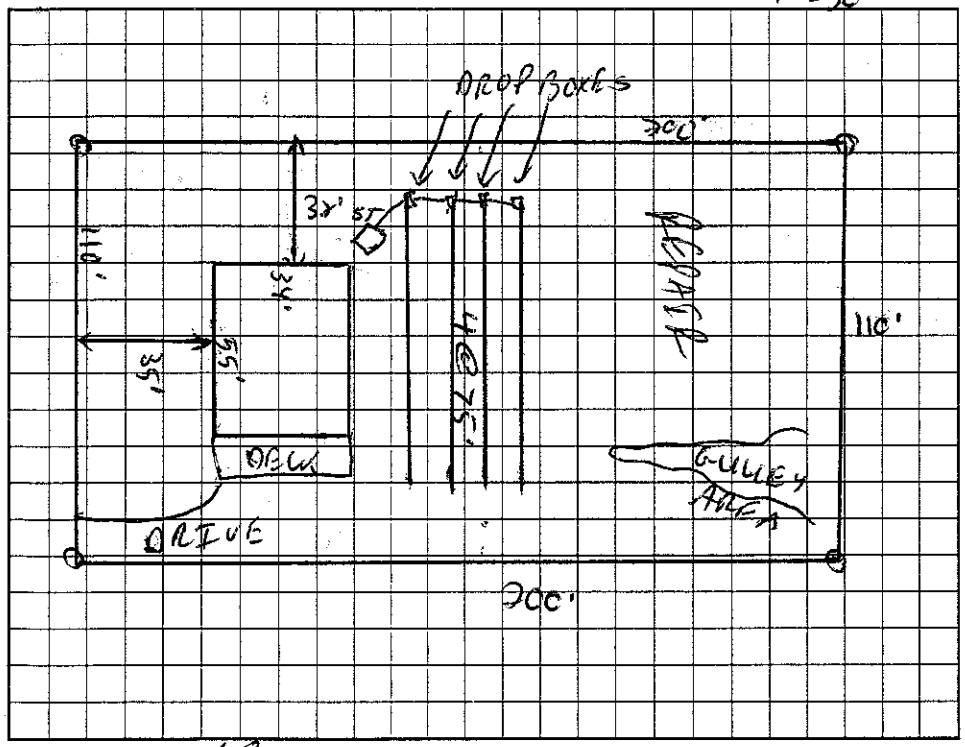

AS BUILT SKETCH

Installed as Shown per Initial Site Sketch

Permit can be suspended or revoked if any false information is supplied toward securing the permit/any unauthorized changes are made to the site/any unauthorized changes are made in the installation of the system. Improvement Permit with plat valid without expiration. Improvement Permit with site plan valid for sixty months. Authorization to Construct is valid for a period equal to that of Improvement Permit – not to exceed sixty months.

Signed: date 3-24-03 Installed by: Craig Thompson

Improvement Permit by: date 3/24/03 Operation Permit by: William O. Jett date 3/27/03

Authorization to Construct by: date 3/24/03 Existing System Inspection by: date

HEALTH DEPT. COPY: WHITE OWNER COPY (FINAL): YELLOW OWNER COPY (INITIAL): PINK