IREDELL COUNTY HEALTH DEPARTMENT

STATESVILLE 704-878-5305 VCI MOORESVILLE 704-664-5281

IMPROVEMENT PERMIT / AUTHORIZATION TO CONSTRUCT / OPERATION PERMIT / EXISTING SYSTEM INSPECTION

PERMIT# 108866 PIN# 4705966273 DATE 12/11/02

OWNER OR CONTRACTOR STONES EDGE INC / FLEETWOOD PHONE: Business 663-2220 Home

ADDRESS 130 LAZY LANE MOORESVILLE NC 28117

LOCATION 64W - TL LEPPARD FARM - TL STONES EDGE - TL GRANSONG - TR ZIRCON - TL TITANIUM on LT.

SUBDIVISION STONES EDGE BLOCK / SECTION LOT 84 LOT AREA .505AC SITE CLASS PS DESIGN FLOW 360GPD L.T.A.R. .30 PP/K

Septic Tank: 1000 Gallons: STB 1012 Date 12-5-02

Pump Tank: Gallons: PT Date

Pump Make: Model Serial No

Nitrification Field: No Fields 1 Square Feet 900 Linear Feet 300

No Lines 3@100' Trench Width 36" Max Trench Bottom Depth 36" Gravel Depth N/A

☑ New System ☐ Repair System Type: I II (III) IV V VI

System Description: GRAVITY 25% REDUCTION

Repair System Description: GRAV/PUMP SAME

Maintenance Agreement Required: ☐ Yes ☑ No

☑ House/Mod Home ☐ Mobile Home ☐ Business ☐ Other

No Bedrooms 3 No. Bathrooms 3 No Employees


☐ Slab ☑ Crawl Space ☐ Basement w/plumbing ☐ Basement wo/plumbing

Water Supply: ☐ Individual ☒ Public ☐ Community


Comments/Conditions:

Comments/Conditions: - ST. Riser Installed
- Tuff-Tite Filter
- 48 Chambers Installed (Infiltration)

INITIAL SITE SKETCH 1"=50'

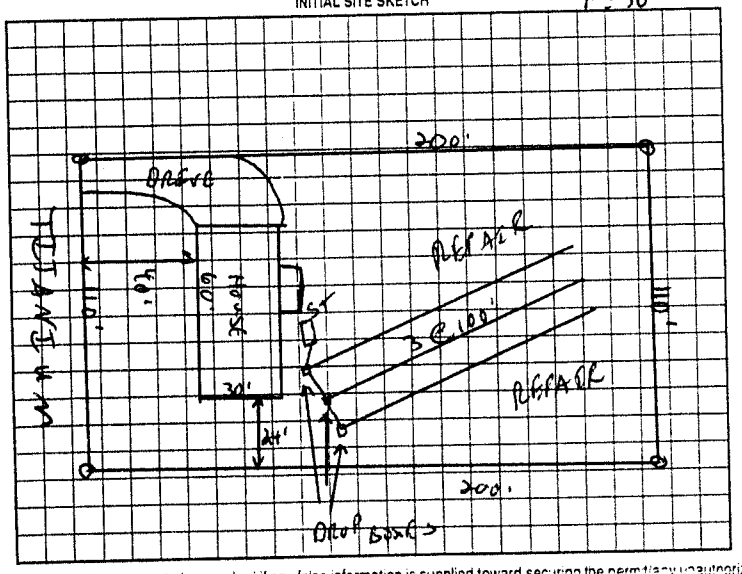

AS BUILT SKETCH

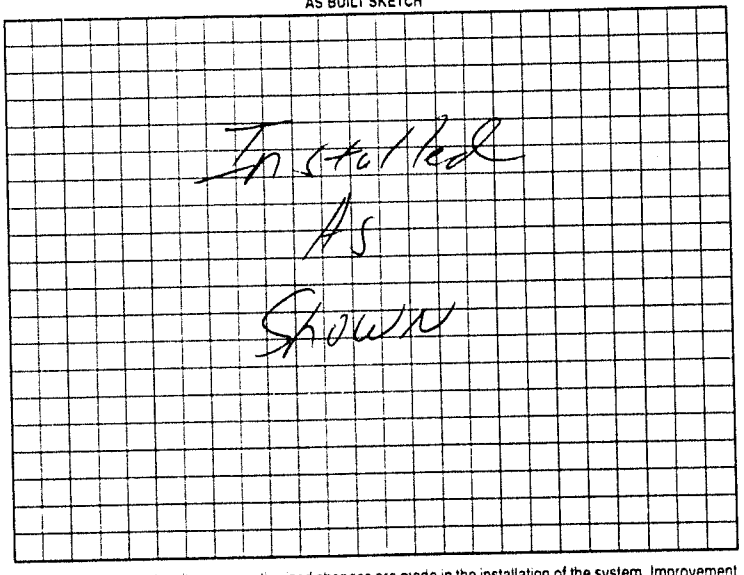

Permit can be suspended or revoked if any false information is supplied toward securing the permit/any unauthorized changes are made to the site any unauthorized changes are made in the installation of the system. Improvement Permit with plat valid without expiration. Improvement Permit with site plan valid for sixty months. Authorization to Construct is valid for a period equal to that of Improvement Permit – not to exceed sixty months

Signed: Renee M. Taylor date 12-11-02 Installed by Craig Thompson

Improvement Permit by: C. Ozmore RS date 12/11/02 Operation Permit by: William Johnson date 12/16/02

Authorization to Construct by: C. Ozmore RS date 12/11/02 Existing System Inspection by: date

HEALTH DEPT COPY WHITE OWNER COPY (FINAL) YELLOW OWNER COPY (INITIAL) PINK