IREDELL COUNTY HEALTH DEPARTMENT

STATESVILLE 704-878-5305 (130) (C1) MOORESVILLE 704-664-5281

IMPROVEMENT PERMIT / AUTHORIZATION TO CONSTRUCT / OPERATION PERMIT / EXISTING SYSTEM INSPECTION

PERMIT# ~~1089~~ 106704 PIN# 4705967827 DATE 11/5/02

OWNER OR CONTRACTOR STONES EDGE INC PHONE: Business 663-2220 Home

ADDRESS 130 LAZY LANE MOORESVILLE NC

LOCATION 64(W) - TL LEPPARD FARM - TL STONESEDGE - TL GEMSTONE - TR ZIRCON - TL TITANEUM - ON RT.

SUBDIVISION STONESEDGE BLOCK / SECTION LOT 78 LOT AREA 30,000 ft² SITE CLASS PS DESIGN FLOW 360 GPD L.T.A.R. .36 GPD/FT²

Septic Tank: 1000 Gallons: STB 1012 Date 7-7-02
Pump Tank: Gallons: PT Date
Pump Make: Model Serial No.
Nitrification Field: No Fields 1 Square Feet 900 Linear Feet 300
No Lines 4@75' Trench Width 36" Max Trench Bottom Depth 36"

☑ New System ☐ Repair System Type: I II (III) IV V VI
System Description: GRAVITY INNOVATIVE
Repair System Description: PUMP PANEL
Maintenance Agreement Required: ☐ Yes ☑ No
Gravel Depth N/A ☐ Slab ☑ Crawl Space ☐ Basement w/plumbing ☐ Basement wo/plumbing


☑ House/Mod. Home No. Bedrooms 3
☐ Mobile Home No. Bathrooms 3
☐ Business No. Employees
☐ Other

Water Supply: ☐ Individual ☑ Public ☐ Community

Comments/Conditions: 1) SMOOTH UP AREA OVER DRAINFIELD

Comments/Conditions: ① SEPTIC TANK WITH MARKER INSTALLED USING "TUFTITE" FILTER ② SYSTEM INSTALLED DURING PERIOD OF WET SOIL CONDITIONS

INITIAL SITE SKETCH 1" = 50'

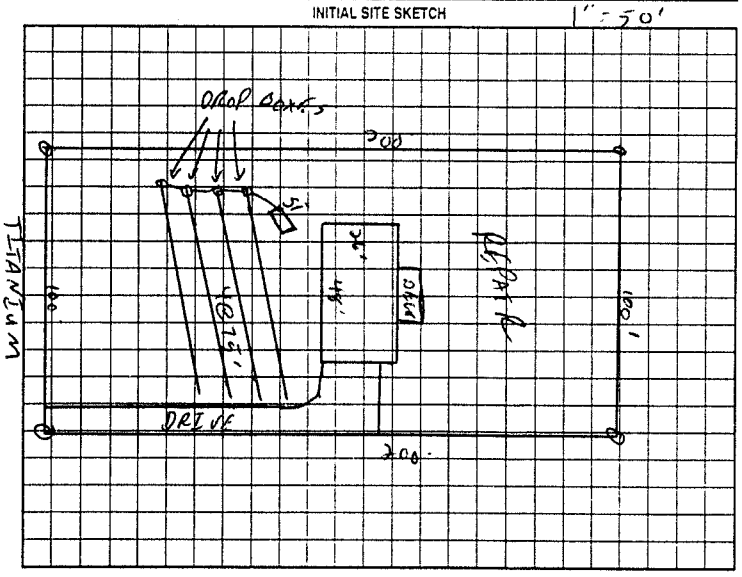

AS BUILT SKETCH

SYSTEM INSTALLED ACCORDING TO INITIAL SITE SKETCH USING 48 'INFILTRATOR' CHAMBERS

Permit can be suspended or revoked if any false information is supplied toward securing the permit/any unauthorized changes are made to the site any unauthorized changes are made in the installation of the system. Improvement Permit with plat valid without expiration. Improvement Permit with site plan valid for sixty months. Authorization to Construct is valid for a period equal to that of Improvement Permit – not to exceed sixty months

Signed: date Installed by CRAIG THOMPSON

Improvement Permit by: C. Gaz RS date 11/5/02 Operation Permit by: STEVE HEARICK date 11-15-02

Authorization to Construct by: C. Gaz RS date 11/5/02 Existing System Inspection by: date

HEALTH DEPT COPY WHITE OWNER COPY (FINAL) YELLOW OWNER COPY (INITIAL) PINK