3:30

IREDELL COUNTY HEALTH DEPARTMENT - *ENVIRONMENTAL HEALTH* ☑ STATESVILLE OFFICE 704-878-5305 ☐ MOORESVILLE OFFICE 704-664-5281

IMPROVEMENT PERMIT / AUTHORIZATION TO CONSTRUCT / OPERATION PERMIT / EXISTING SYSTEM INSPECTION

PERMIT # 169573 PIN # 4705-97-4906 DATE 15 December 2011

OWNER Hayday Investments APPLICANT: Clayton Howell PHONE: Home/Cell # (704) 239-3693 Business #

SITE ADDRESS 183 Village Point Dr. Stat. OWNER / APPLICANT ADDRESS

SITE DIRECTIONS Hwy 90 W Turn Village Point Dr. on left past Heartwood Dr.

SUBDIVISION Village Point BLOCK / SECTION LOT # 7 LOT AREA 0.57ac. DESIGN FLOW 360gpd L.T.A.R. 0.3/1.1

Septic Tank 1000 Gallons: STB 760 Date 4-10-13

Pump Tank Gallons: PT Date

Pump Make Model Serial #

No. Nitrification Fields: 1 No. Lines 4 Linear Feet 300

Trench Width 36" Max. Trench Bottom Depth 36" Gravel Depth N/A

☑ New System ☐ Repair ☐ Expansion System Type I II (III) IV V VI

System Description: 25% Reduction System

Repair System Description: 50% Reduction System

Maintenance Agreement Required ☐ YES ☑ NO

☑ GRAVITY ☐ PRESSURE

☑ Residence No. Bedrooms 3

☐ Business No. Persons

☐ Other No. Employees

☐ Slab ☑ Crawl Space


☐ Basement w/plumbing ☐ Basement w/o plumbing

Water Supply: ☐ Private ☑ Public ☐ Community


Comments / Conditions

Follow contour / Keep out of headslope

INITIAL SITE SKETCH

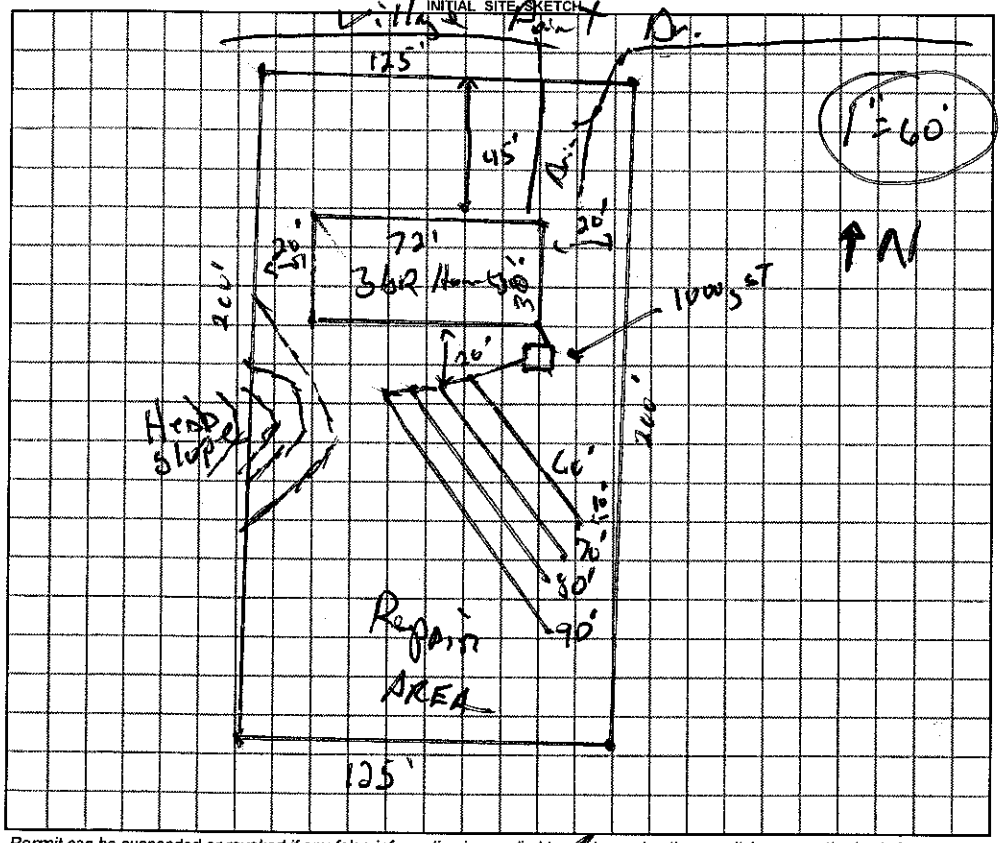

AS BUILT SKETCH

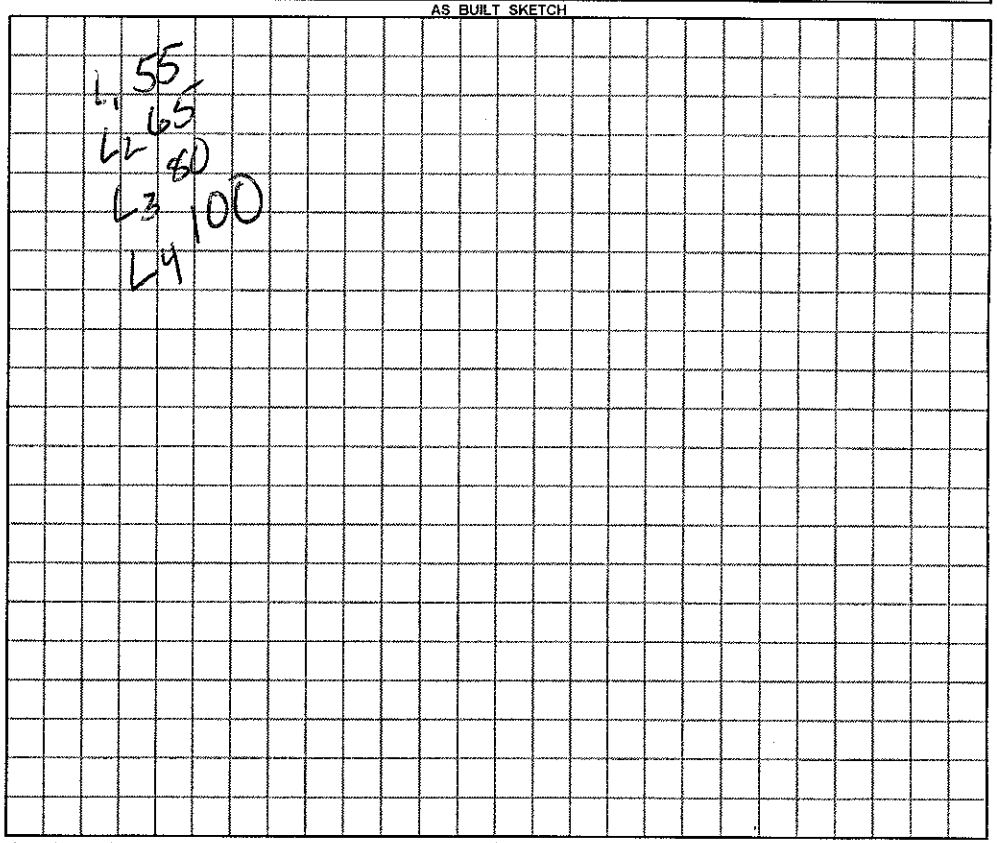

Permit can be suspended or revoked if any false information is supplied toward securing the permit / any unauthorized changes are made to the site / any unauthorized changes are made in the installation of the system.

☐ ***IMPROVEMENT PERMIT*** with plat valid without expiration ☑ ***IMPROVEMENT PERMIT*** with [redacted] site plan valid 60 mo. 12-27-11 ☐ ***AUTHORIZATION TO CONSTRUCT*** valid for period equal to IMPROVEMENT PERMIT--not to exceed 60 mo.

Owner / Applicant Signature: Clayton Howell Date 12/16/11 Installed by: Abee's Grading

IMPROVEMENT PERMIT by: REHS Date 15 December OPERATION PERMIT by: REHS Date 9-5-13

AUTHORIZATION TO CONSTRUCT by: REHS Date 12-27-11 Existing System Inspected by: REHS Date

YOU SHOULD CONTACT A LOCATOR SERVICE PRIOR TO ANY EXCAVATION

White Copy – Environmental Health YELLOW COPY (Final) Owner / Applicant PINK COPY (Initial) Owner / Applicant